


STATE OF KANSAS
STATE CORPORATION COMMISSION

WELL PLUGGING RECORD

Give All Information Completely
Make Required Affidavit
Mail or Deliver Report to
Conservation Division
State Corporation Comm.
245 North Water
Wichita, KS 67202

Seward County, Sec. 15 Twp. 32S Rge. 34 ~~XX~~/~~W~~
Location as "NE/CNW $\frac{1}{4}$ SW $\frac{1}{4}$ " or footage from lines
300' FSL, 100' FEL NW/4
Lease Owner Cities Service Company
Lease Name Kapp B Well No. 2
Office Address 3545 N.W. 58th Street - Oklahoma City, OK 73112
Character of Well (Completed as ~~XXXXXX~~ Dry Hole)
Dry Hole
Date Well completed August 11, 1977
Application for plugging filed May 1, 1980
Application for plugging approved May 15, 1980
Plugging commenced May 25, 1980
Plugging completed May 31, 1980
Reason for abandonment of well or producing formation

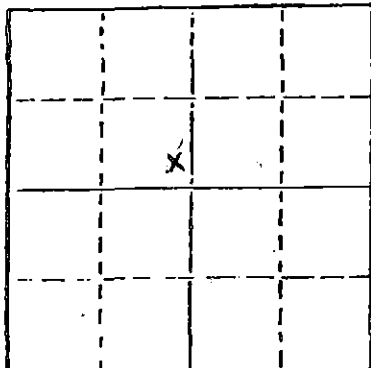

Locate well correctly on above
Section Plot

Dry Hole
If a producing well is abandoned, date of last production 19

Was permission obtained from the Conservation Division or its agents before plugging was commenced? Yes

Name of Conservation Agent who supervised plugging of this well Clarence Thomas
Producing formation: Depth to top Bottom Total Depth of Well 3130'
Show depth and thickness of all water, oil and gas formations.

OIL, GAS OR WATER RECORDS

CASING RECORD

| FORMATION | CONTENT | FROM | TO | SIZE | PUT IN | PULLED OUT |
|---------------|---------|-------|-------|-------|--------|------------|
| Council Grove | Dry | 2970' | 2986' | 4-1/2 | 3115 | 1380' |
| | | | | | | |
| | | | | | | |

Describe in detail the manner in which the well was plugged, indicating where the mud fluid was placed and the method or methods used in introducing it into the hold. If cement or other plugs were used, state the character of same and depth placed, from feet to feet for each plug set. Council Grove Perfs Squeezed w/150 sx cmt. Loaded hole w/drlg. mud. Worked pipe, Pulled csg. to 780. Spotted 35 sx plug 685-780'. Pulled csg. to 350'. Spotted 25 sx cmt 282-350'. Pulled rest of csg. Rec. total 33jts. 1380' 4 1/2" csg. Cut off csg & cap well. Spotted 10 sx cmt from 3 to 30'. Welded on cap w/company name and date.

6-23-80
RECEIVED
JUN 25 1980
STATE CORPORATION COMMISSION
Wichita, Kansas

(If additional description is necessary, use BACK of this sheet)

Name of Plugging Contractor Sargent's Casing Pulling Company

STATE OF Oklahoma COUNTY OF Oklahoma
H. E. Massey (employee of ~~XXXXXX~~ or (~~XXXXXX~~ operator)

of the above-described well, being first duly sworn on oath, says: That I have knowledge of the facts, statements, and matters herein contained and the log of the above-described well as filed and that the same are true and correct. So help me God.

(Signature) H. E. Massey H. E. Massey
3545 N.W. 58th Street - Okla. City, OK 73112
(Address)

SUBSCRIBED AND SWORN TO before me this 18th day of June, 1980

Joyce S. Darter
Joyce S. Darter Notary Public.

My commission expires 6-10-84