


Give All Information Completely  
Make Required Affidavit  
Mail or Deliver Report to:  
Conservation Division  
State Corporation Commission  
211 No. Broadway  
Wichita, Kansas

WELL PLUGGING RECORD

NORTH

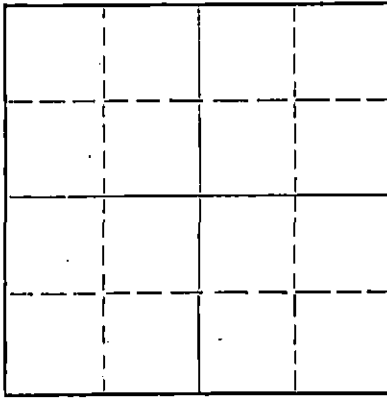

Locate well correctly on above  
Section Plat

Kingman County. Sec. 5 Twp. 29S Rge. 8W (X) (W)

Location as "NE/CNW/SW" or footage from lines C NE NW

Lease Owner: Leben Drilling, Inc.

Lease Name: ~~XXXXXXXXXXXX~~ Specht Well No. 1

Office Address: Box 486, Great Bend, Kansas

Character of Well (completed as Oil, Gas or Dry Hole) Dry Hole

Date well completed 1-7-65 19

Application for plugging filed 1-7-65 19

Application for plugging approved 1-7-65 19

Plugging commenced 1-7-65 19

Plugging completed: 1-7-65 19

Reason for abandonment of well or producing formation Dry Hole

If a producing well is abandoned, date of last production \_\_\_\_\_ 19

Was permission obtained from the Conservation Division or its agents before plugging was commenced? yes

Name of Conservation Agent who supervised plugging of this well Archie Elving, Pratt, Kansas

Producing formation \_\_\_\_\_ Depth to top \_\_\_\_\_ Bottom \_\_\_\_\_ Total Depth of Well 4565 Feet

Show depth and thickness of all water, oil and gas formations.

OIL, GAS OR WATER RECORDS

CASING RECORD

FORMATION	CONTENT	FROM	TO	SIZE	PUT IN	PULLED OUT
				8 5/8"	187'	none

Describe in detail the manner in which the well was plugged, indicating where the mud fluid was placed and the method or methods used in introducing it into the hole. If cement or other plugs were used, state the character of same and depth placed, from \_\_\_\_\_ feet to \_\_\_\_\_ feet for each plug set.

Mud to 200' Plug 1 1/2 sacks hulls 25 sacks cement  
Mud to 40' Plug 1/2 sk. hulls 10 sks. cement  
2 sacks in rathole.

RECEIVED  
STATE CORPORATION COMMISSION

1-13-65 JAN 12 1965

CONSERVATION DIVISION  
Wichita, Kansas

(If additional description is necessary, use BACK of this sheet)

Name of Plugging Contractor Leben Drilling, Inc.

Address Box 486, Great Bend, Kansas

STATE OF KANSAS, COUNTY OF BARTON, ss.

Leslie Kite (employee of owner) or (owner or operator) of the above-described well, being first duly sworn on oath, says: That I have knowledge of the facts, statements, and matters herein contained and the log of the above-described well as filed and that the same are true and correct. So help me God.

(Signature) Leslie Kite

P. O. Box 486, Great Bend, Kansas  
(Address)

SUBSCRIBED AND SWORN TO before me this 11th day of January, 1965

My commission expires April 1, 1967

Wanda D. Nichols  
Notary Public.

DRILLER'S LOG

COMPANY: Leben Drilling, Inc.  
 CONTRACTOR: LEBEN DRILLING, INC.  
 FARM: SPECHT #1  
 LOCATION: C NE NW Sec. 5-29S-8W  
 KINGMAN COUNTY, KANSAS  
 COMMENCED: 12-15-64  
 COMPLETED: 107-65

0	1225	Shale
1225	1534	Lime & Shale
1534	1740	Shale & Lime
1740	1915	Lime & Shale
1915	2245	Shale & Lime
2245	2516	Shale & Sand
2516	3460	Shale & Lime
3460	3938	Lime
3938	4035	Lime & Shale
4035	4112	Lime
4112	4145	Shale & Lime
4145	4160	Mississippi
4160	4275	Lime
4275	4295	Lime & Chert
4295	4370	Lime & Shale
4370	4470	Shale
4470	4483	Lime & Shale
4483	4510	Lime
4510	4518	Sand
4518	4565	Sand & Shale
	4565	Rotary Total Depth - D. & A.

RECEIVED  
 STATE CORPORATION COMMISSION  
 JAN 13 1965  
 CONSERVATION DIVISION  
 Wichita, Kansas

Set 187' of 8 5/8" surface casing with 95 sacks 60-40 Posmix

I, Leslie Kite, do hereby certify that the above and foregoing is a true and correct copy of the log of the Specht #1 well, located C NE NW of Section 5, Township 29 South, Range 8 West, Kingman County, Kansas, as reflected by the files of Leben Drilling, Inc.

*Leslie Kite*  
 Leslie Kite

STATE OF KANSAS )  
 )  
 COUNTY OF BARTON ) SS

Subscribed and sworn to before me, a Notary Public, in and for Barton County, Kansas, this 11th day of January, 1965.

*Ulanda Nichols*  
 Ulanda Nichols

My Commission Expires  
 April 1, 1967