

STATE OF KANSAS  
STATE CORPORATION COMMISSION

Form CP-4 *RP*

WELL PLUGGING RECORD

Give All Information Completely  
Make Required Affidavit  
Mail or Deliver Report to:  
Conservation Division,  
State Corporation Commission  
211 No. Broadway  
Wichita, Kansas

Kingman County, Sec. 3 Twp. 29 Rge. 8 (E) (W)

Location as "NE/CNW/SW" or footage from lines G NE SW

Lease Owner Continental Oil Company

Lease Name V. Shepherd Well No. 1

Office Address P. O. Box 267 Great Bend, Kansas

Character of Well (completed as Oil, Gas or Dry Hole)

Date well completed 19

Application for plugging filed 19

Application for plugging approved 19

Plugging commenced 5-25-64 19


Plugging completed 6-10-64 19

Reason for abandonment of well or producing formation

Dry

If a producing well is abandoned, date of last production 19

Was permission obtained from the Conservation Division or its agents before plugging was commenced? Yes

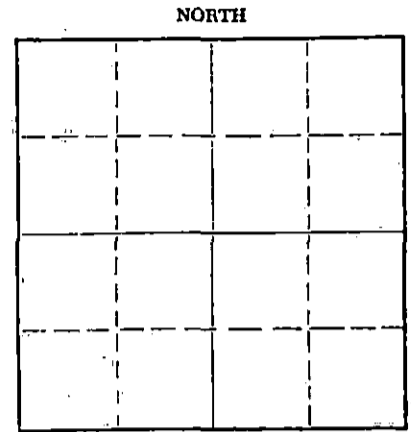

Name of Conservation Agent who supervised plugging of this well Archie V. Elving

Producing formation Depth to top Bottom Total Depth of Well 4793 Feet

Show depth and thickness of all water, oil and gas formations.

OIL, GAS OR WATER RECORDS

CASING RECORD

FORMATION	CONTENT	FROM	TO	SIZE	PUT IN	PULLED OUT
				10 3/4	268	None
				5 1/2	None	3576

Describe in detail the manner in which the well was plugged, indicating where the mud fluid was placed and the method or methods used in introducing it into the hole. If cement or other plugs were used, state the character of same and depth placed, from feet to feet for each plug set.

Cleaned out cellar. Blowing gas.  
Trying to kill well with water and could not. Pumped 15 sacks of cement to 4050'.  
Digging ditches to drain off water.  
Working pipe.  
Working pipe. Shot pipe at 3700' - 3640' and 3550'. Pulling pipe.  
Pulling pipe.  
Pulling pipe. Mudded to 260'. Build rock bridge.  
Mudded hole to 275'. Build 10' rock bridge. Mixed 30 sacks of cement.  
Mudded hole to 40'. Build rock bridge. Mixed 15 sacks for cap on well.

RECEIVED  
STATE CORPORATION COMMISSION  
JUN 12 1964

CONSERVATION DIVISION  
Wichita, Kansas

(If additional description is necessary, use BACK of this sheet)

Name of Plugging Contractor Forbes Casing Pulling, Inc.

Address P. O. Box 221 Great Bend, Kansas

STATE OF Kansas, COUNTY OF Barton, ss.  
J. O. Forbes (employee of owner) or (owner or operator) of the above-described

well, being first duly sworn on oath, says: That I have knowledge of the facts, statements, and matters herein contained and the log of the above-described well as filed and that the same are true and correct. So help me God.

(Signature) *J. O. Forbes*  
P. O. Box 221 Great Bend, Kansas  
(Address)

SUBSCRIBED AND SWORN TO before me this 11 day of June, 1964

*Glenn O. [Signature]*  
Notary Public.

My commission expires May 27, 1965

VIGLA SHEPHERD NO. 1  

WELL RECORD

OPERATOR: CONTINENTAL OIL COMPANY  
 PONCA CITY, OKLAHOMA

CONTRACTOR: NORMAN-JOHNSON DRILLING CO., INC.  
 320 INDIANA PARK BUILDING, EVANSVILLE 5, INDIANA

COMMENCED: APRIL 21, 1964  
 COMPLETED: MAY 11, 1964

CASING: P&L 270.82 ft. 10-7/8" Surface Casing cemented w/100 sacks cement  
 P&L 4720 ft. 5-1/2" Production Casing cemented w/100 sacks cement

<u>FROM</u>	<u>TO</u>	<u>FORMATION</u>
0	105	Sand
105	205	Sand & Shale
205	270	Shale & Shale
270	690	Sand & Red Bed
690	1050	Sand, Red bed & Shale
1050	1410	Shale & Anhydrite
1410	1840	Lime
1840	1925	Lime & Shale
1925	2425	Shale & Lime
2425	2535	Lime, Shale & Sand
2535	2700	Lime & Shale
2700	3215	Lime
3215	3296	Lime & Shale
3296	3402	Lime, Shale & Sand
3402	3495	Lime & Shale
3495	3600	Lime
3600	3675	Lime & Shale
3675	4150	Lime
4150	4305	Lime & Shale
4305	4450	Shale & Lime
4450	4505	Lime & Shale
4505	4520	Lime
4520	4575	Core (L)
4575	4717	Lime
<u>TOTAL DEPTH</u>	<u>4717</u>	<u>UNKNOWN</u>

**RECEIVED**  
 STATE CORPORATION COMMISSION

MAY 25 1964

CONSERVATION DIVISION  
 Wichita, Kansas

The undersigned, NORMAN-JOHNSON DRILLING CO., INC., hereby certifies that the above log is a true and correct log of the formation encountered in drilling the above well in accordance with the Daily Field log reports.

NORMAN-JOHNSON DRILLING CO., INC.

BY  
 Joe Foster, Vice Secretary

Subscribed and sworn to before me  
 on this 15th day of May, 1964

*[Signature]*  
 Notary Public

My Commission expires  
 November 5, 1965

Geological Dept. (2) attention Betty Little