

15-095-01290-0000


STATE OF KANSAS
STATE CORPORATION COMMISSION

WELL PLUGGING RECORD

Give All Information Completely
Make Required Affidavit
Mail or Deliver Report to:
Conservation Division
State Corporation Commission
211 N. Broadway
Wichita, Kansas

Kingman County. Sec. 12 Twp. 29 Rge. 9 (E) W (W)
Location as "NE/CNW%SW%" or footage from lines SW SW NW
Lease Owner Tennessee Gas Transmission Co.
Lease Name Fred Teismeyer Well No. 1
Office Address Great Bend, Kansas
Character of Well (completed as Oil, Gas or Dry Hole) Oil
Date well completed _____ 19____
Application for plugging filed _____ 19____
Application for plugging approved _____ 19____
Plugging commenced 7-5-57 _____ 19____
Plugging completed 7-10-57 _____ 19____
Reason for abandonment of well or producing formation Depletion

NORTH

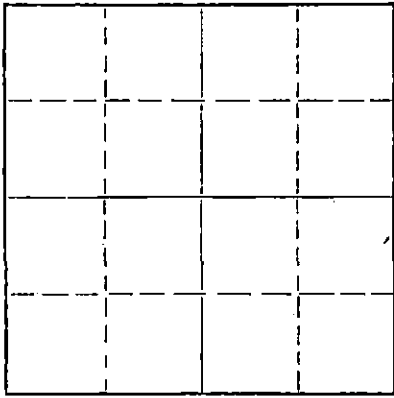

Locate well correctly on above
Section Plat

If a producing well is abandoned, date of last production _____ 19____
Was permission obtained from the Conservation Division or its agents before plugging was commenced? yes

Name of Conservation Agent who supervised plugging of this well Merle Rives
Producing formation _____ Depth to top _____ Bottom _____ Total Depth of Well 4523 Feet
Show depth and thickness of all water, oil and gas formations.

OIL, GAS OR WATER RECORDS

CASING RECORD

FORMATION	CONTENT	FROM	TO	SIZE	PUT IN	PULLED OUT
				8-5/8	249'	none
				5 1/2"	4500'	3192'

Describe in detail the manner in which the well was plugged, indicating where the mud fluid was placed and the method or methods used in introducing it into the hole. If cement or other plugs were used, state the character of same and depth placed, from _____ feet to _____ feet for each plug set.

Checked the hole to 4280' and found it open. Filled w/sand to 4200' and ran 5 sacks of cement to 4165'. Pulled casing. Bled hole. Mudded to 255', set a 10' rock bridge to 245' and ran 20 sacks of cement. Mudded hole to 40', set a rock bridge and ran 10 sacks of cement to base of cellar.

Plugging completed

(If additional description is necessary, use BACK of this sheet)

Name of Plugging Contractor West Supply Co., Inc.
Address Chase, Kansas

STATE OF Kansas, COUNTY OF Rice, ss.
Glen E. Armour (employee of owner) or (owner) of the above-described well, being first duly sworn on oath, says: That I have knowledge of the facts, statements, and matters herein contained and the log of the above-described well as filed and that the same are true and correct. So help me God.

(Signature) Glen E. Armour

(Address)

SUBSCRIBED AND SWORN to before me this 11th day of July, 1957

My commission expires May 20, 1958

Notary Public
RECEIVED
STATE CORPORATION COMMISSION

PLUGGING
FILE SEC 12 T. 29 R. 9W
BOOK PAGE 25 LINE 34

JUL 13 1957

CONSERVATION DIVISION
Kansas

DRILLERS LOG

#1 FRED TIESMEYER

CASING RECORD:
253' of new 8-5/8"
at 250'.
4524' of 5 1/2" pipe
at 4520'.
TOTAL DEPTH: 4523'

COMPANY: Tennessee Gas
Transmission Co.
CONTRACTOR: Strata Drilling, Inc.
COMMENCED: April 29, 1957
COMPLETED: May 15, 1957

LOCATION: SW SW NW
Sec. 12-29S-9W
Kingman County,
Kansas
ELEVATION: 1712' RE
1710' DF
1707' GL

<u>FORMATION</u>	<u>FROM</u>	<u>TO</u>	<u>REMARKS</u>
Surface Soil and Sand	0	55	
Red Rock and Shale	55	215	
Red Bed	215	645	
Shale and Shell	645	1175	
Lime and Shale	1175	3535	
Lime	3535	4035	
Lime and Shale	4035	4217	
Lime, Shale and Chert	4217	4280	
Lime and Shale	4280	4518	

TOTAL DEPTH 4518' RE

I certify that this is a true and correct copy of the above log to the best of my knowledge.

STRATA DRILLING, INC.

Charles W. Steincamp
CHARLES W. STEINCAMP, President

Subscribed and sworn to before me this 20th day of May, 1957.

Mary O. Johnson
Notary Public

My Commission Expires:
November 21, 1959

RECEIVED
STATE CORPORATION COMMISSION
FEB 5 1958
CONSERVATION DIVISION
Wichita, Kansas

STATE OF KANSAS)
COUNTY OF BARTON) SS.

PLUGGING
FILE SEC. 12 T. 29 R. 94
BOOK PAGE 25 LINE 33