

15-095-00406-0000


STATE OF KANSAS
STATE CORPORATION COMMISSION

Give All Information Completely
Make Required Affidavit
Mail or Deliver Report to:
Conservation Division
State Corporation Commission
800 Bittling Building
Wichita, Kansas

WELL PLUGGING RECORD

Kingman County, Sec. 12 Twp. 29 Rge. 9 (E) (W)

Location as "NE/CNW/SW" or footage from lines: SW SW NW
Lease Owner: Stearns Drilling Company
Lease Name: Tiesmeyer Well No. 1
Office Address: Box 313, Russell, Kansas
Character of Well (completed as Oil, Gas or Dry Hole): Dry Hole
Date well completed: December 31 1953
Application for plugging filed: January 21 (verbal) 1954
Application for plugging approved: February 1, (written) 1954
Plugging commenced: January 22 1954
Plugging completed: January 29 1954
Reason for abandonment of well or producing formation: Dry

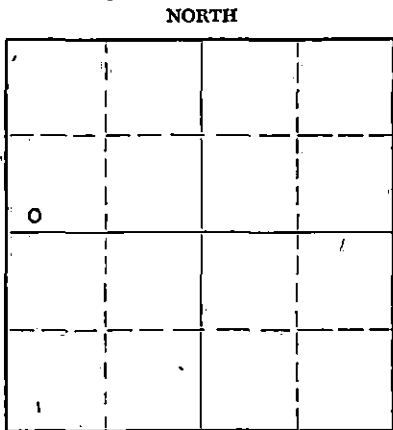

Locate well correctly on above Section Plat

If a producing well is abandoned, date of last production: 19
Was permission obtained from the Conservation Division or its agents before plugging was commenced? Yes

Name of Conservation Agent who supervised plugging of this well: Ruel E. Durkee
Producing formation: Depth to top: Bottom: Total Depth of Well: 4696 Feet
Show depth and thickness of all water, oil and gas formations.

OIL, GAS OR WATER RECORDS

CASING RECORD

FORMATION	CONTENT	FROM	TO	SIZE	PUT IN	PULLED OUT
				8 5/8"	256.45	None
				5 1/2"	4367'	1621.35'

Describe in detail the manner in which the well was plugged, indicating where the mud fluid was placed and the method or methods used in introducing it into the hole. If cement or other plugs were used, state the character of same and depth placed, from feet to feet for each plug set.

Bridge set at 3915, dumped 7 sacks of cement,
Top of cement at 3848. Mud to 240'.
Dumped 17 sacks cement at 240'. Mud to 20'.
Dumped 7 sacks cement at 20'.

(If additional description is necessary, use BACK of this sheet)

Name of Plugging Contractor:
Address:

STATE OF KANSAS, COUNTY OF RUSSELL, ss.
O. G. STEARNS (employee of owner) or (operator) of the above-described well, being first duly sworn on oath, says: That I have knowledge of the facts, statements, and matters herein contained and the log of the above-described well as filed and that the same are true and correct. So help me God.

(Signature) [Signature]
Russell, Kansas (Address)

SUBSCRIBED AND SWORN TO before me this 1st day of February, 1954

[Signature] Notary Public.

My commission expires June 20, 1957

24-2675-S 2-52-20M

PLUGGING
FILE SEC 12 T 29 R 9W
BOOK PAGE 11 LINE 7

2-2-54

- TIESMEYER #1 WELL -

Operator: Stearns Drilling Company
 Contractor: Stearns Drilling Company
 Commencement Date: November 16, 1953
 Completion Date: December 9, 1953

Location: SW-SW-NW
 Section 12-29-9,
 Kingman Co., Kansas

Casing Record:

8 5/8" 256.45' Cemented with 150 sacks.
 5 1/2" 4402.00' Cemented with 125 sacks.

WELL LOG

Cellar	0	10
Shale	10	60
Red Bed	60	252
Red Bed and Shale	252	360
Anhydrite	360	365
Shale and Shells	365	1415
Lime and Shale	1415	1615
Lime	1615	1715
Lime and Shale	1715	1970
Lime	1970	2130
Lime and Shale	2130	2475
Shale and Shells	2475	2700
Lime and Shale	2700	2910
Lime	2910	2960
Lime and Shale	2960	3053
Lime	3053	3260
Lime and Shale	3260	3280
Lime	3280	3490
Lime and Shale	3490	3606
Lime	3606	3932
Lime and Shale	3932	3946
Lime	3946	4010
Lime and Shale	4010	4116
Lime	4116	4200
Shale and Chert	4200	4220
Chert	4220	4225
Mississippi Chert	4225	4272
Chert	4272	4282
Lime	4282	4343
Shale	4343	4357
Lime and Shale	4357	4518
Viola Lime	4518	4556
Chert	4556	4567
Lime and Chert	4567	4597
Simpson Sand	4597	4601
Shale and Sand	4601	4676
Arbuckle	4676	4696
Total Depth:	4696	

RECEIVED
 COUNTY COMMISSION
 KINGMAN COUNTY, KANSAS
 JAN 22 1954

STATE OF KANSAS, COUNTY OF RUSSELL: SS:

I hereby certify that the above information is true and correct to the best of my knowledge.

Harold Arbuckle

Subscribed and Sworn to before me this 22nd day of January, 1954.

My Commission Expires:

March 3, 1957

PLUGGING

FILE SEC 12 T 29 R 9W

PAGE 4 LINE 7

Zita Denney
 Notary Public