


15-095-00416-0000

STATE OF KANSAS  
STATE CORPORATION COMMISSION

Give All Information Completely  
Make Required Affidavit  
Mail or Deliver Report to:  
Conservation Division  
State Corporation Commission  
800 Bitting Building  
Wichita, Kansas

WELL PLUGGING RECORD

NORTH

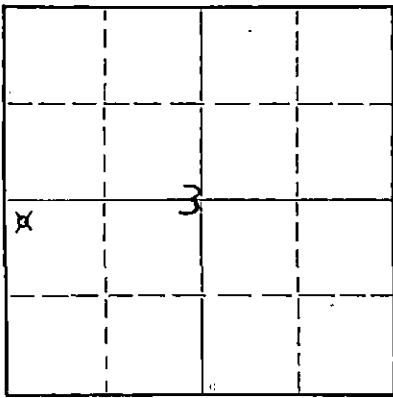

Locate well correctly on above  
Section Plat

Kingman County. Sec. 3 Twp. 29 Rge. 9 (E) W (W)  
Location as "NE/CNW/SW" or footage from lines NW NW SW  
Lease Owner Murphy Oil Co. of Okla., Inc.  
Lease Name McKenna "B" Well No. 1  
Office Address 400 Midstates Building, Tulsa, Oklahoma  
Character of Well (completed as Oil, Gas or Dry Hole) dry hole  
Date well completed December 25, 19 58  
Application for plugging filed December 24, 19 58  
Application for plugging approved December 24, 19 58  
Plugging commenced December 26, 19 58  
Plugging completed December 26, 19 58  
Reason for abandonment of well or producing formation

If a producing well is abandoned, date of last production 19  
Was permission obtained from the Conservation Division or its agents before plugging was com-  
menced? yes

Name of Conservation Agent who supervised plugging of this well Fred Hampel - Pretty Prairie, Kansas  
Producing formation Depth to top Bottom Total Depth of Well 4656 Feet  
Show depth and thickness of all water, oil and gas formations.

OIL, GAS OR WATER RECORDS

CASING RECORD

FORMATION	CONTENT	FROM	TO	SIZE	PUT IN	PULLED OUT
Water formations		0	275	8-5/8"	275	None

Describe in detail the manner in which the well was plugged, indicating where the mud fluid was placed and the method or methods used in introducing it into the hole. If cement or other plugs were used, state the character of same and depth placed, from feet to feet for each plug set.

Filled hole with heavy mud to 240 feet, dumped 1/4 sack of hulls. Plug wrapped in burlap set at 240 feet. Dumped 20 sacks cement on top of plug. Filled hole with heavy mud to 35'. Plug wrapped in burlap set at 35 feet. Dumped 10 sacks of cement on top of plug. Welded cap on top of surface pipe. Filled rathole with cement.

RECEIVED  
STATE CORPORATION COMMISSION  
JAN 2 1959  
CONSERVATION DIVISION  
Wichita, Kansas

(If additional description is necessary, use BACK of this sheet)  
Name of Plugging Contractor Barbour Drilling Company  
Address Suite 4, 1645 East 21st Street, Tulsa 14, Oklahoma

STATE OF Oklahoma, COUNTY OF Tulsa  
E. W. Pribyl, contractor (employee or owner) or (owner or operator) of the above-described well, being first duly sworn on oath, says: That I have knowledge of the facts, statements, and matters herein contained and the log of the above-described well as filed and that the same are true and correct. So help me God. BARBOUR DRILLING COMPANY

(Signature) E. W. Pribyl  
Suite 4, 1645 East 21st Street, Tulsa 14, Okla.  
(Address)

SUBSCRIBED AND SWORN TO before me this 29th day of December, 19 58

My commission expires July 27, 1961

Merry Jane Burt  
RECEIVED  
DEC 30 1958  
MOCO-QKLA., INC.  
PLUGGING  
FILE SEC 3 T. 29 R. 9W  
BOOK PAGE 7 LINE 26

McKENNA "B" #1

NW SW Section 3-29S-9W  
Kingman County, Kansas  
Murphy Oil Company Of Oklahoma, Inc.

8-5/8" O. D. casing cemented at 275'

Drilling commenced December 6, 1958  
Drilling completed December 25, 1958

FROM	TO	FORMATION	REMARKS
0'	40'	Sand	
40	80	Clay, sand & shale	
80	200	Red bed, shale & shells	
200	545	Red bed & shells	8-5/8" O. D. casing cemented with 250 sacks cement at 275'
545	1380	Shale & shells	
1380	1420	Anhydrite	
1420	1875	Lime & shale	
1875	2280	Lime	
2280	2445	Lime & shale	
2445	2625	Shale & lime	
2625	3125	Lime & shale	
3125	3295	Lime	
3295	3377	Shale & lime	
3377	3475	Douglas sand	
3475	3575	Shale & lime	
3575	4145	Lime	
4145	4180	Shale & chat (Mississippi)	
4180	4245	Chert	
4245	4395	Lime & shale	
4395	4467	Shale & lime	
4467	4495	Chert	
4495	4517	Lime & chert	
4517	4558	Sand	
4558	4588	Sand & shale	
4588	4600	Sand	
4600	4631	Sand & shale	
4631	4645	Lime	
4645	4656	Arbuckle lime	Well plugged
T.D.	4656'		

This is a true copy of the driller's log as shown on the drilling tickets.

MURPHY OIL COMPANY  
BARBOUR DRILLING COMPANY

By: *C. W. Dill*

Subscribed and sworn to before me on this 29th day of December, 1958.

*Merry Jane Burt*  
Notary Public

My commission expires July 27, 1961

PLUGGING  
FILE SEC 3 T29 R 9W  
BOOK PAGE 7 LINE 26