


STATE OF KANSAS  
STATE CORPORATION COMMISSION

Give All Information Completely  
Make Required Affidavit  
Mail or Deliver Report to:  
Conservation Division  
State Corporation Commission  
211 No. Broadway  
Wichita, Kansas

WELL PLUGGING RECORD

NORTH

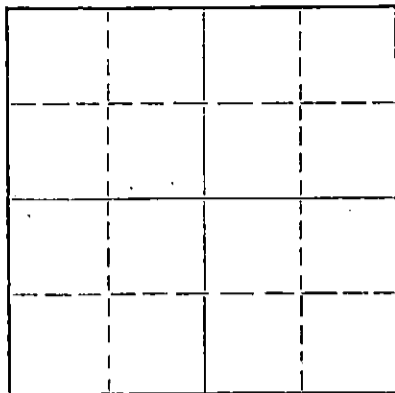

Locate well correctly on above  
Section Flat

KINGMAN COUNTY, KANSAS County, Sec. 3 Twp. 29S Rge. 9W (E) (W)  
Location as "NE/CNW/SW" or footage from lines C SE NW  
Lease Owner WALTERS DRILLING & BOA, ET AL  
Lease Name BECKER Well No. 1  
Office Address 510 Orpheum Building, Wichita, Kansas  
Character of Well (completed as Oil, Gas or Dry Hole) D & A  
Date well completed November 6th, 1960 19  
Application for plugging filed November 6th, 1960 19  
Application for plugging approved November 6th, 1960 19  
Plugging commenced November 6th, 1960 19  
Plugging completed November 6th, 1960 19  
Reason for abandonment of well or producing formation

If a producing well is abandoned, date of last production 19  
Was permission obtained from the Conservation Division or its agents before plugging was commenced? YES

Name of Conservation Agent who supervised plugging of this well Fred W. Hampel, Pretty Prairie, Kansas  
Producing formation Depth to top Bottom Total Depth of Well 4560 Feet  
Show depth and thickness of all water, oil and gas formations.

OIL, GAS OR WATER RECORDS

CASING RECORD

FORMATION	CONTENT	FROM	TO	SIZE	PUT IN	PULLED OUT
				8-5;8"	215'	

Describe in detail the manner in which the well was plugged, indicating where the mud fluid was placed and the method or methods used in introducing it into the hole. If cement or other plugs were used, state the character of same and depth placed, from feet to feet for each plug set.

Fill with heavy mud to 210' set plug with  
15 sx cement & 1/4 sx hulls thru drill pipe.  
Filled with heavy mud to 35' set solid  
bridge with 10 sx cement to base of cellar.  
Job complete. 11-6-60.

RECEIVED  
STATE CORPORATION COMMISSION  
NOV 16 1960  
CONSERVATION DIVISION  
WICHITA, KANSAS

(If additional description is necessary, use BACK of this sheet)  
Name of Plugging Contractor WALTERS DRILLING CO.  
Address 510 Orpheum Building, Wichita, Kansas

STATE OF KANSAS, COUNTY OF SEDGWICK, ss.  
R. L. Abel, (employee of owner) or (owner or operator) of the above-described well, being first duly sworn on oath, says: That I have knowledge of the facts, statements, and matters herein contained and the log of the above-described well as filed and that the same are true and correct. So help me God.

(Signature) R. L. Abel  
R. L. Abel, of Walters Drilling Co.  
510 Orpheum Bldg, Wichita 2, Kansas  
(Address)

SUBSCRIBED AND SWORN TO before me this 11th day of November 19 60

My commission expires August 11th, 1962  
Patricia M. Edwards, Notary Public.



DRILLERS LOG

OPERATOR: WALTERS, BOA, ET AL 510 Orpheum Building Wichita, Kansas	FARM NAME: #1 BECKER
contractor: WALTERS DRILLING CO. 510 Orpheum Building Wichita, Kansas	LOCATION: C SE NW, 3-29S-9W Kingman Co, Kansas
CASING: 8-5/8" @ 215' (175 sx cmt)	COMMENCED: October 23rd, 1960 COMPLETED: November 6th, 1960
R.T.D. 4560'	ELEVATION: 1690' KB PRODUCTION: D & A

FORMATION RECORD

Depths indicate bottom of formations encountered .

Soil & Clay	5
Sand	85
Shale & Shells	215
Rock & Shale	750
Shale & Shells	1360
Lime & Shale	1545
Lime	1800
Lime & Shale	2100
Shale & Lime	2275
Lime & Shale	3393
Sand & Shale	3495
Lime & Shale	3582
Lime	3935
Lime & Shale	4178
Miss Lime & Chert	4230
Lime	4265
Lime & Shale	4325
Shale & Lime	4375
Shale	4448
Shale & Lime	4473
Viola Lime	4481
Lime & Shale	4540
Sand	4560
R.T.D.	4560

**RECEIVED**  
STATE CORPORATION COMMISSION

NOV 16 1960

CONSERVATION DIVISION  
Wichita, Kansas

CERTIFICATION

STATE OF KANSAS )  
COUNTY OF SEDGWICK ) SS:

I, R. L. Abel of Walters Drilling Co., upon oath state that the above and foregoing is a true and correct copy of the Driller's Log of the Walters, et al #1 Becker well.

R. L. Abel  
R. L. Abel

Subscribed and sworn to me this 11th day of November, 1960.

Patricia M. Edwards  
Patricia M. Edwards, Notary Public

My commission expires: August 11th, 1962.