

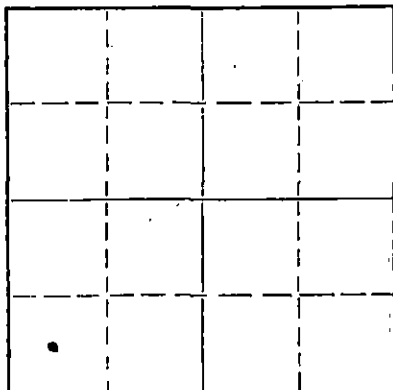
STATE OF KANSAS
STATE CORPORATION COMMISSION

Form CP-4

Give All Information Completely
Make Required Affidavit
Mail or Deliver Report to:
Conservation Division
State Corporation Commission
212 No. Market
Wichita, Kansas

WELL PLUGGING RECORD

NORTH

Locate well correctly on above
Section Plat

Kingman County, Sec. 3 Twp. 29S Rge. 9 (E) W (W)

Location as "NE/CNW/SW" or footage from lines C/SW/SW

Lease Owner Sierra Petroleum Co., Inc.

Lease Name McKenna

Well No. 1

Office Address 211 N. Broadway, Wichita, Kansas 67202

Character of Well (completed as Oil, Gas or Dry Hole) Dry Hole

Date well completed 3-6 1967

Application for plugging filed 3-5 1967

Application for plugging approved 3-5 1967

Plugging commenced 3-6 1967

Plugging completed 3-6 1967

Reason for abandonment of well or producing formation Dry Hole

If a producing well is abandoned, date of last production 19

Was permission obtained from the Conservation Division or its agents before plugging was commenced? Yes

Name of Conservation Agent who supervised plugging of this well Archie V. Elving

Producing formation Depth to top Bottom Total Depth of Well Feet

Show depth and thickness of all water, oil and gas formations.

OIL, GAS OR WATER RECORDS

CASING RECORD

FORMATION	CONTENT	FROM	TO	SIZE	PUT IN	PULLED OUT
Surface Pipe	3-6	1967	238	8 5/8	238	-0-

Describe in detail the manner in which the well was plugged, indicating where the mud fluid was placed and the method or methods used in introducing it into the hole. If cement or other plugs were used, state the character of same and depth placed, from feet to feet for each plug set.

Filled hole w/ heavy mud.

#1 plug @ 220' w/20 sacks cement & 1/2 Sk. hulls

#2 plug @ 40' w/8 sacks cement & 1/2 Sk. hulls

#3 plug in rat hole w/ 2 sacks cement.

Name of Plugging Contractor S & S Drilling Co.
Address Box 645, Great Bend, Kansas 67530

STATE OF Kansas, COUNTY OF Barton, ss.
T. D. Sweetman

(employee of owner) or (owner or operator) of the above-described well, being first duly sworn on oath, says: That I have knowledge of the facts, statements, and matters herein contained and the log of the above-described well as filed and that the same are true and correct. So help me God.

(Signature)

Box 645, Great Bend, Kansas 67530

(Address)

SUBSCRIBED AND SWORN TO before me this 7th day of March, 1967

My commission expires 5/9/67

Notary Public.

WELL LOG
McKenna #1
G/ SW/SW of Sec. 3-29S-9W
Kingman County, Kansas

FROM	TO	
0	90	Sand
90	238	Red Bed
238	1215	Red Bed & Shale
1215	2190	Shale & Lime
2190	2440	Shale, Lime, & Sand
2440	3010	Shale & Lime
3010		Total Depth

RECEIVED
STATE OF KANSAS
MAR 9 1967
CONSERVATION DIVISION
WICHITA, KANSAS

STATE OF KANSAS

COUNTY OF BARTON ss

T. D. Sweetman, Partner of S & S Drilling Company, being first duly sworn on oath says: That I have knowledge of the facts, statements and matters herein contained and the log of the above described well as filed and that the same are true and correct.

T. D. Sweetman
T. D. Sweetman

Suscribed and sworn before me this 7th day of March, 1967

Heath L. Boyd
Notary Public Barton County

My Commission Expires 5/9/67