

DISTRICT CONSERVATION AGENT'S REPORT

TO:

State Corporation Commission
Conservation Division
800 Bitting Building
Wichita, Kansas

FILE NO. 15-173-60553-0000

LOCATION CS² SE-NE

SEC. 1 TWP. 28 RGE. 4W

Dry Hole Abandoned Oil Well _____ Abandoned Gas Well _____

I have today completed supervision of plugging of:

Well No. 1 Lease Peutz

Operator Russ Drilling Address Tulsa

Field Wildcat County Sedgwick

Total Depth 4349 Feet.

(Describe briefly the manner in which the well was plugged)


Mud 4349-110' Notes: Rotary

Cement 110-90' hole - 100' - 110'

Mud 90-10'

Cement 10'-Surface

7-29-42

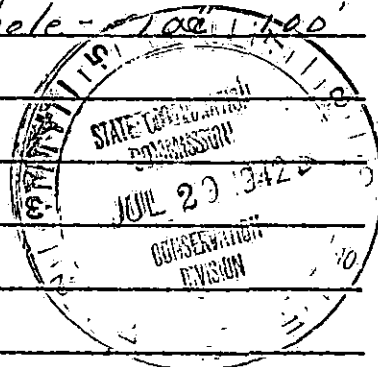

PLUGGING
FILE 1 28 4E
BOOK 44 PAGE 33

R. O. Whicians
District Conservation Agent

Date 7-18-42

37