


STATE OF KANSAS
STATE CORPORATION COMMISSION

WELL PLUGGING RECORD

Give All Information Completely
Make Required Affidavit
Mail or Deliver Report to
Conservation Division
State Corporation Comm.
245 North Water
Wichita, KS 67202

Stafford County. Sec. 15 Twp. 22S Rge. 13 E/W
Location as "NE/CNW $\frac{1}{4}$ /SW $\frac{1}{4}$ " or footage from lines SE NE NW
Lease Owner Lee Phillips Oil Company
Lease Name Farago Well No. 2
Office Address 125 No. Market, Ste 1532, Wichita, Ks.
Character of Well (Completed as Oil, Gas or Dry Hole) _____

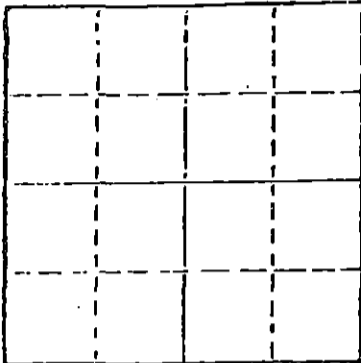

Locate well correctly on above
Section Plot

Dry Hole
Date Well completed June 26 1981
Application for plugging filed June 26 1981
Application for plugging approved June 26 1981
Plugging commenced June 26 1981
Plugging completed June 26 1981
Reason for abandonment of well or producing formation _____

Dry Hole
If a producing well is abandoned, date of last production _____
NA 19 _____

Was permission obtained from the Conservation Division or
its agents before plugging was commenced? Yes

Name of Conservation Agent who supervised plugging of this well Maurice V. Leslie-present
Producing formation -- Depth to top -- Bottom -- Total Depth of Well 3810
Show depth and thickness of all water, oil and gas formations.

OIL, GAS OR WATER RECORDS

CASING RECORD

FORMATION	CONTENT	FROM	TO	SIZE	PUT IN	PULLED OUT
		0'	305'	8-5/8"	295'	None

Describe in detail the manner in which the well was plugged, indicating where the mud fluid was placed and the method or methods used in introducing it into the hold. If cement or other plugs were used, state the character of same and depth placed, from _____ feet to _____ feet for each plug set.

Plugged with 125 sacks 50/50 pozmix:

1st plug @ 650' with 60 sacks

2nd plug @ 300' with 40 sacks

3rd plug @ 40' with 10 sacks

RECEIVED
STATE CORPORATION COMMISSION

10 sacks in rathole

5 sacks in mousehole

JUL 10 1981

CONSERVATION DIVISION
Wichita Kansas

(If additional description is necessary, use BACK of this sheet) 7-10-81

Name of Plugging Contractor Halliburton

STATE OF KANSAS COUNTY OF SEDGWICK, ss.

John Jay Darrah, Jr. Agent (employee of owner) or (owner or operator)
of the above-described well, being first duly sworn on oath, says: That I have knowledge of
the facts, statements, and matters herein contained and the log of the above-described well
as filed and that the same are true and correct. So help me God.

(Signature)

405 Century Plaza, Wichita, Ks. 67202
(Address)

SUBSCRIBED AND SWORN TO before me this 9th day of July, 19 81

Dianne R. Fowler Notary Public.

My commission expires 8/25/84

D R I L L E R S ' L O G

COMPANY: Lee Phillips Oil Company
 CONTRACTOR: MALLARD DRILLING CO., INC.
 405 Century Plaza
 Wichita, Kansas 67202

WELL NAME: #2 Farago
 DESCRIPTION: SE NE NW
 Section 15-22S-13W

RIG NO.: 1

COUNTY: Stafford

TOTAL DEPTH: 3810

ELEVATION: 1890 GR

COMMENCED: June 18, 1981

COMPLETED: June 26, 1981

CASING RECORD:

8 jts. new 24# 8-5/8" surface casing

D & A

<u>FORMATION</u>	<u>FROM</u>	<u>TO</u>	<u>REMARKS</u>
Surface soil	0	315	Ran 295' new 24# 8-5/8" surface casing; set and cemented with 280 sacks 50/50 pozmix, 2% gel, 3% CC at 305'. Cement circulated. Plug down at 4:00 p.m., June 18, 1981.
Shale and Red Bed	315	750	
Shale	750	1775	
Shale w/Lime streaks	1775	2148	
Shale and Lime	2148	3514	
Lime	3514	3595	
Lime and Shale	3595	3763	DST #1 - CFS
Arbuckle	3763	3810	DST #2 - CFS

Hole plugged with 50/50 pozmix, 4% gel, 3% CC, as follows: 60 sacks at 650', 40 sacks at 300', 10 sacks at 40', 10 sacks in rat-hole and 5 sacks in mousehole. 2 sacks in waterwell. Plugging completed at 7:30 a.m., June 26, 1981.

STATE OF KANSAS)
) SS.
 COUNTY OF SEDGWICK)

I, JOHN JAY DARRAH, JR. of MALLARD DRILLING CO., INC., certify that this is a true and correct copy of the log of the #2 Farago well, to the best of my knowledge.

John Jay Darrah, Jr.
 John Jay Darrah, Jr., President

SUBSCRIBED AND SWORN to before me this 9th day of July, 1981.

My Commission Expires:
 August 25, 1984

Dianne R. Fowler
 Dianne R. Fowler, Notary Public
 STATE CORPORATION COMMISSIONER

JUL 10 1981
 CONSERVATION DIVISION
 Wichita, Kansas