


STATE OF KANSAS
STATE CORPORATION COMMISSION

WELL PLUGGING RECORD

Give All Information Completely
Make Required Affidavit
Mail or Deliver Report to:
Conservation Division
State Corporation Commission
800 Basing Building
Wichita, Kansas

OR
~~WELL PLUGGING RECORD~~ Strike out upper line when reporting plugging off formations.

NORTH

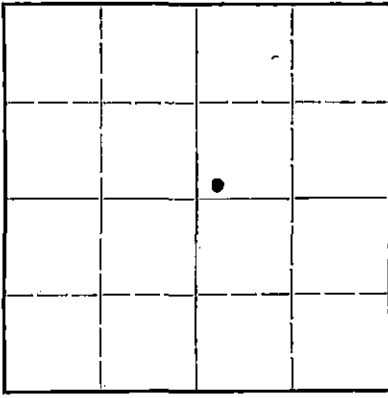

Locate well correctly on above Section Flat

Stafford County. Sec. 15 Twp. 22S. Rge. (E) 13 (W)
Location as "NE1/4NW1/4SW1/4" or footage from lines NE/4, 330' fm Sth & West lines
Lease Owner Sinclair Prairie Oil Co
Lease Name O.G. Soeken Well No. 1
Office Address Box 521, Tulsa, Okla.
Character of Well (completed as Oil, Gas or Dry Hole) Dry hole
Date well completed July 28 1947
Application for plugging filed July 30 1947
Application for plugging approved Verbally July 28 1947
Plugging commenced July 28 1947
Plugging completed July 29 1947
Reason for abandonment of well or producing formation Completed as dry hole

If a producing well is abandoned, date of last production - 19
Was permission obtained from the Conservation Division or its agents before plugging was commenced? Yes Verbal permit

Name of Conservation Agent who supervised plugging of this well H.W. Kerr
Producing formation none Depth to top Bottom Total Depth of Well 3910' Feet
Show depth and thickness of all water, oil and gas formations.

OIL, GAS OR WATER RECORDS

CASING RECORD

Formation	Content	From	To	Size	Put In	Pulled Out
Lan-Kc	dry top	3403		10-3/4	295	0
Conglomerate	" "	3691				

Describe in detail the manner in which the well was plugged, indicating where the mud fluid was placed and the method or methods used in introducing it into the hold. If cement or other plugs were used, state the character of same and depth placed, from feet to feet for each plug set.
3910' - 280' heavy mud
280' - set plug 20 sx cmt to 240'
240' - 30' heavy mud
30' set plug & 20 sx cmt to bottom cellar.

8-4-47



(If additional description is necessary, use BACK of this sheet)

Correspondence regarding this well should be addressed to Mr. E.H. Gibbons
Address Bx 774, Great Bend, Kas

STATE OF Kansas, COUNTY OF Barton, ss.
I, E.H. Gibbons (employee of owner) or (owner) of the above-described well, being first duly sworn on oath, says: That I have knowledge of the facts, statements, and matters herein contained and the log of the above-described well as filed and that the same are true and correct. So help me God.

(Signature) *E.H. Gibbons*

Box 774, Great Bend, Kas. (Address)

SUBSCRIBED AND SWORN TO before me this 30th day of July 1947
Louis Lundy Notary Public.

My commission expires November 15, 1950

PLUGGING
FILE SEC 15 T 22 R 13 W
BOOK PAGE 23 LINE 35

Sinclair Prairie Oil Co

Log of well #1, O. G. Soeken - Dry hole
NE/4, 15-22S-13W, Stafford Co., Kas.

Strata	Thickness	Total Depth.
Sand & Clay	220	220
Shale & Shells	55	275
Shale, Shells & red bed	20	295
Red Bed & Shale	480	775
Anhydrite	25	800
Shale	100	900
Shale & shells	450	1350
Salt Shale & Shells	100	1450
Shale & Shells	120	1570
Shale & Lime	1020	2590
Shale & Shell	60	2650
Shale & Lime	295	2945
Lime	115	3060
Lime Broken	70	3130
Lime	180	3310
Lime & Shale	110	3420
Lime	265	3685
Lime	5	3690
Shale	40	3730
Shale Red	10	3740
Conglomerate	170	3910

295' of 10-3/4" pipe set, cemented with 250 sacks cement

