


15-009-15112-0000
WELL PLUGGING RECORD

Give All Information Completely
Make Required Affidavit
Mail or Deliver Report to:
Conservation Division
State Corporation Commission
211 No. Broadway
Wichita, Kansas

NORTH

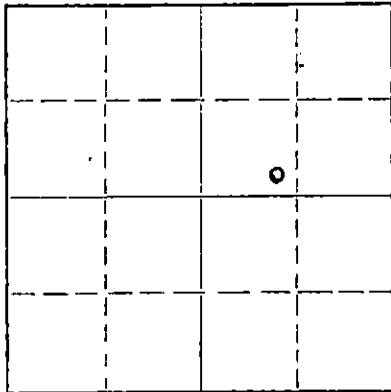

Locate well correctly on above
Section Plat

Barton County. Sec. 33 Twp. 16 Rge. 11 (X) (W)
Location as "NE/CNW*SW*" or footage from lines SE SW NE
Lease Owner Colorado Oil Company - Division of Colorado Oil and Gas Corporation
Lease Name Bernstorf-Janke Well No. 6
Office Address Box 1030, Wichita, Kansas 67201
Character of Well (completed as Oil, Gas or Dry Hole) Oil
Date well completed July 12 1941
Application for plugging filed October 2 1964
Application for plugging approved October 5 1964
Plugging commenced October 7 1964
Plugging completed October 7 1964
Reason for abandonment of well or producing formation Production depleted

If a producing well is abandoned, date of last production August 16 1964
Was permission obtained from the Conservation Division or its agents before plugging was commenced? Yes

Name of Conservation Agent who supervised plugging of this well Don Truan
Producing formation Arbuckle Depth to top 3343 Bottom _____ Total Depth of Well 3348 Feet
Show depth and thickness of all water, oil and gas formations.

OIL, GAS OR WATER RECORDS

CASING RECORD

FORMATION	CONTENT	FROM	TO	SIZE	PUT IN	PULLED OUT
				8-5/8"	61	None
				7"	343	None
				4-1/2"	3343	None

Describe in detail the manner in which the well was plugged, indicating where the mud fluid was placed and the method or methods used in introducing it into the hole. If cement or other plugs were used, state the character of same and depth placed, from _____ feet to _____ feet for each plug set.

Casing, tubing and rods parted @ 1200'. Left in hole

Drlg. mud from 526' to 404'
Cement from 404' to surface

RECEIVED
STATE CORPORATION COMMISSION
11-02-64 NOV 2 1964
CONSERVATION DIVISION
Wichita, Kansas

(If additional description is necessary, use BACK of this sheet)

Name of Plugging Contractor Halliburton Company
Address Duncan, Oklahoma

STATE OF KANSAS, COUNTY OF SEDGWICK, ss.
Bill K. Henrichs (employee of owner) or (owner or operator) of the above-described well, being first duly sworn on oath, says: That I have knowledge of the facts, statements, and matters herein contained and the log of the above-described well as filed and that the same are true and correct. So help me God.

(Signature) Bill K. Henrichs
Bill K. Henrichs
P. O. Box 1030, Wichita, Kansas
(Address)

SUBSCRIBED AND SWORN TO before me this 30th day of October 1964

My commission expires August 19, 1967

Helen L. Martin
Helen L. Martin
Notary Public.

THE DERBY OIL COMPANY

Record of Well No. 6
 Location SE SW NE
 Contractor: Crow Drilling Co.
 Drilling Commenced 6-24-41
 Drilling Completed 7-12-41

Bernstorff-Janke Farm
 Sec 33 Twp. 16 Rge. 11W
 County: Barton
 Elevation: 1916

CASING RECORD

Size	Feet	Kind	Weight
8 5/8" - 61'			
8" O.D.-343'	404		Cem with 110 Sax lone Star & 15 sax Atlas Early strength Cem.
4 1/2"	3543		Cem with 100 sax Ash Grove Cem.
Formation		Bottom	

Shale	0-33
Sand	80
Shale & Shells	583
Red Bed	685
Shell & Shells	715
Anhydrite	765
Shale & Shells	1089
Shale	1126
Shale & Shells	1305
Shale & Salt	1417
Shale & Lime Shells	1538
Shale	1567
Shale & Shells	1644
Shale & Lime streak	1754
Lime	1787
Lime & chert	1873
Lime	1884
Cherty lime	1886
Lime	1923
Lime & Chert	1933
Lime	1979
Lime & Shale	2272
Shale	2389
Shale & Lime	2471
Lime	2501
Shale & Lime	2731
Lime	2745
Lime Chert	2754
Lime	2961
Lime & shale	3028
Shale & Lime Streaks	3055
Lime	3344

CABLE TOOL RECORD

Drill plug & drill deeper to 3348' - 3000' oil 30 minutes.
 Swb 149.88 oil in 2 1/2 hrs.
 1850' off bottom - 500 acid.
 Swab 268 oil 4 hrs 2000' O.B.
 Echo. Pot. 19,599 oil - No. wtr.

GEOLOGICAL DATA

Lansing	3074
Arbuckle	3343
T.D.	3348

RECEIVED
 STATE CORPORATION COMMISSION
 OCT 5 - 1964
 CONSERVATION DIVISION
 Wichita, Kansas