


STATE OF KANSAS  
STATE CORPORATION COMMISSION

Form CP-4

WELL PLUGGING RECORD

Give All Information Completely  
Make Required Affidavit  
Mail or Deliver Report to:  
Conservation Division  
State Corporation Commission  
212 No. Market  
Wichita, Kansas 67202

NORTH

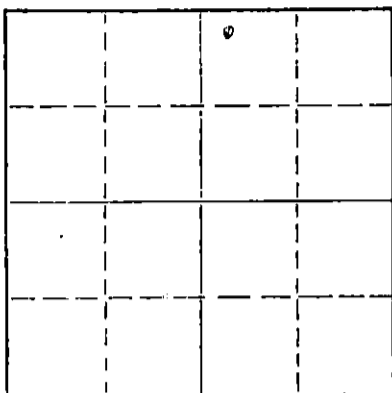

Locate well correctly on above  
Section Plat

Barton County. Sec. 33 Twp. 16S Rge. (E) 11(W)  
Location as "NE/CNWSW" or footage from lines NW NW NE  
Lease Owner Carl W. Boxberger  
Lease Name Bernstorf-Janke Well No. 1  
Office Address P.O. Box 474, Great Bend, KS 67530  
Character of Well (completed as Oil, Gas or Dry Hole) Oil  
Date well completed 10-29 1984  
Application for plugging filed 11-20 1984  
Application for plugging approved 11-29 1984  
Plugging commenced 12-13 1984  
Plugging completed 12-13 1984  
Reason for abandonment of well or producing formation casing parted and casing collapsed at 1345 ft.  
If a producing well is abandoned, date of last production unknown 1981  
Was permission obtained from the Conservation Division or its agents before plugging was commenced? YES

Name of Conservation Agent who supervised plugging of this well Gilbert Scheck  
Producing formation Arbuckle Depth to top 3351 Bottom 3362 Total Depth of Well 3362 Feet  
Show depth and thickness of all water, oil and gas formations.

OIL, GAS OR WATER RECORDS

CASING RECORD

FORMATION	CONTENT	FROM	TO	SIZE	PUT IN	PULLED OUT
		surface	425	7"	425	none
		surface	3351	4 1/2"	3351	none
Lansing-Kansas City		3085	3351			
Arbuckle		3351	3362			

Describe in detail the manner in which the well was plugged, indicating where the mud fluid was placed and the method or methods used in introducing it into the hole. If cement or other plugs were used, state the character of same and depth placed, from \_\_\_\_\_ feet to \_\_\_\_\_ feet for each plug set.

7-11-58 Well was squeezed with 225 sacks poz mix cement from 760' (perforated) to surface. Pumping cement down 4 1/2" casing and circulate out braden head on surface - had full returns for first 150 sacks displaced then close in and squeeze to 500#.

12-13-84 Sun Cementing hooked onto 4 1/2" casing pumped 4 sack hulls, 25 sacks 50-50 poz with 6% gel and 3% cacl, 12 sacks gel, 4" plug, 100 sacks 50-50 poz with 6% gel and 3% cacl max. pres. 300# CIP 100# completed 12-13-84 3:15 pm

STATE CORPORATION COMMISSION  
Wichita, Kansas  
1-11-84

(If additional description is necessary, use BACK of this sheet)

Name of Plugging Contractor Sun Cementing  
Address P.O. Box 169, Great Bend, KS 67530

STATE OF Kansas, COUNTY OF Barton, ss.  
Keith Lumpkins (employee of owner) or (owner or operator) of the above-described well, being first duly sworn on oath, says: That I have knowledge of the facts, statements, and matters herein contained and the log of the above-described well as filed and that the same are true and correct. So help me God.

(Signature) X Carl W. Boxberger  
Carl W. Boxberger  
P.O. Box 474, Great Bend, KS 67530  
(Address)

SUBSCRIBED AND SWORN TO before me this 17<sup>th</sup> day of December, 1984

My commission expires 9-3-87

John Raleigh  
John Raleigh Notary Public.