


WELL PLUGGING RECORD

Give All Information Completely  
Make Required Affidavit  
Mail or Deliver Report to:  
Conservation Division  
State Corporation Commission  
800 Bitting Building  
Wichita, Kansas

NORTH

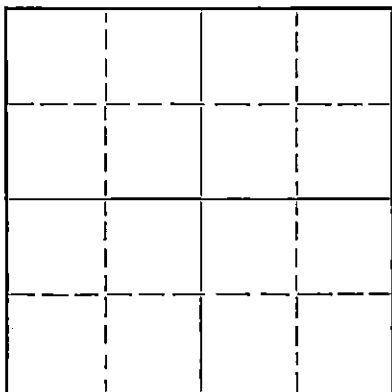

Locate well correctly on above  
Section Plat

Stafford County, Sec. 20, Twp. 23, Rge. (E) 13 (W)  
Location as "NE/CNW $\frac{1}{4}$ SW $\frac{1}{4}$ " or footage from lines SE SE NE  
Lease Owner Cooperative Refinery Association  
Lease Name Schultz B Well No. 1  
Office Address Box 765, Great Bend  
Character of Well (completed as Oil, Gas or Dry Hole) Dry Hole  
Date well completed 10-28-52 19  
Application for plugging filed 10-30-52 19  
Application for plugging approved 10-29-52 19  
Plugging commenced 10-28-52 19  
Plugging completed 10-28-52 19  
Reason for abandonment of well or producing formation

If a producing well is abandoned, date of last production 19  
Was permission obtained from the Conservation Division or its agents before plugging was commenced? Yes

Name of Conservation Agent who supervised plugging of this well M. A. Rives  
Producing formation Depth to top Bottom Total Depth of Well 3683 Feet  
Show depth and thickness of all water, oil and gas formations.

OIL, GAS OR WATER RECORDS

CASING RECORD

Formation	Content	From	To	Size	Put In	Pulled Out
				8-5/8"	317'	

Describe in detail the manner in which the well was plugged, indicating where the mud fluid was placed and the method or methods used in introducing it into the hole. If cement or other plugs were used, state the character of same and depth placed, from feet to feet for each plug set.

Filled to T.D. 3683 with heavy mud, Plugged to 366' set plug, cemented drill pipe 15' sx & filled mud 30' from top, set plug & cemented 10' sx to top surface.

(If additional description is necessary, use BACK of this sheet)


Name of Plugging Contractor Lewis Drilling Co.  
Address 607 Union Nat'l. Bank Building, Wichita, Kansas

STATE OF Kansas, COUNTY OF Barton, ss.  
L. M. Collins (employee of owner) or (owner or operator) of the above-described well, being first duly sworn on oath, says: That I have knowledge of the facts, statements, and matters herein contained and the log of the above-described well as filed and that the same are true and correct. So help me God.

(Signature) L M Collins  
10-52 Cooperative Refinery Association (Address)

SUBSCRIBED AND SWORN to before me this 14th day of November, 1952  
Wichita, Kansas  
Therese Alice Datta Notary Public.

My commission expires 9-15-56 23-8390-s 6-51-20M

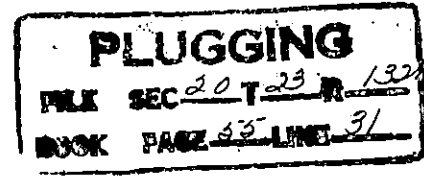

COOPERATIVE REFINERY ASS'N.

Great Bend, Kansas

15-185-11488-0000

DRILLERS LOG

Schultz, B #1  
Sec: 20-23s-13w  
Loc: SE SE NE  
Stafford County, Kansas  
Operator: Cooperative Refinery Association  
Contractor: Lewis Drilling Co.

Comm: 10-17-52  
Comp: 10-28-52  
Casing: 8-5/8" 317' OD  
28# JS w/ 200 sx 2 sx CC  
Production: D&A

0	75	Surface clay
75	175	Blue shale
175	220	Red bed
220	265	Sand
265	317	Shale
317	765	Red bed
765	790	Anhydrite
790	835	Shale & shells
835	1675	Shale & shells
1675	3211	Lime & shale
3211	3280	Shale & lime
3280	3295	Lime & shale
3295	3380	Lime
3380	3500	Lime & shale
3500	3683	Lime T.D.

I certify that this is the true and correct copy of the above log, to the best of my knowledge.

L M Collins

Subscribed and sworn to before me this 11 day of November 1952

Marjorie Alice Dabbs  
Notary Public

My Commission Expires: 9-15-56

RECEIVED  
STATE CORPORATION COMMISSION  
NOV 12 1952  
CONSERVATION DIVISION  
Wichita, Kansas

PLUGGING  
WEL SEC 20T23 R 137  
BOOK PAGE 55 LINE 31