


WELL PLUGGING RECORD

Give All Information Completely
Make Required Affidavit
Mail or Deliver Report to:
Conservation Division
State Corporation Commission
211 No. Broadway
Wichita, Kansas

Stafford County, Sec. 20 Twp. 23 Rge. 13 (E) W (W)

Location as "NE/CNW/SW" or footage from lines NE NE NW
Lease Owner Jay Kornfeld
Lease Name Schultz Well No. 1
Office Address Wichita, Kansas
Character of Well (completed as Oil, Gas or Dry Hole) _____
Date well completed _____ 19____
Application for plugging filed _____ 19____
Application for plugging approved _____ 19____
Plugging commenced 11-7-63 _____ 19____
Plugging completed 11-9-63 _____ 19____
Reason for abandonment of well or producing formation Depleted.

NORTH

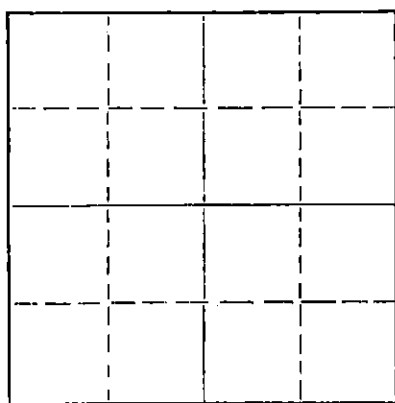

Locate well correctly on above Section Plat

If a producing well is abandoned, date of last production _____ 19____
Was permission obtained from the Conservation Division or its agents before plugging was commenced? yes

Name of Conservation Agent who supervised plugging of this well Archie Elving
Producing formation _____ Depth to top _____ Bottom _____ Total Depth of Well 4 023 Feet
Show depth and thickness of all water, oil and gas formations.

OIL, GAS OR WATER RECORDS

CASING RECORD

FORMATION	CONTENT	FROM	TO	SIZE	PUT IN	PULLED OUT
				8-5/8"	316'	None
				5-1/2"	3770	

Describe in detail the manner in which the well was plugged, indicating where the mud fluid was placed and the method or methods used in introducing it into the hole. If cement or other plugs were used, state the character of same and depth placed, from _____ feet to _____ feet for each plug set.

Checked hole to 3689', sanded to 3625' and dumped 5 sacks of cement @ 3625' with dump bailer. Pulled 5 1/2" casing, set plug @ 275', set rock bridge to 265' and ran 5 sacks of cement @ 265'. Bailed hole to 250' and dumped 20 sacks of cement. Filled hole to 40', set rock bridge to 30' and ran 10 sacks of cement to base of cellar.

RECEIVED
STATE CORPORATION COMMISSION

NOV 15 1963

11-15-63

CONSERVATION DIVISION
Wichita, Kansas

PLUGGING COMPLETE.

(If additional description is necessary, use BACK of this sheet)

Name of Plugging Contractor KNIGHT CASING PULLING COMPANY
Address CHASE, KANSAS

STATE OF KANSAS, COUNTY OF RICE, ss.
Noel J. Knight (employee of owner) or (owner's agent) of the above-described well, being first duly sworn on oath, says: That I have knowledge of the facts, statements, and matters herein contained and the log of the above-described well as filed and that the same are true and correct. So help me God.

(Signature) Noel J. Knight
Chase, Kansas
(Address)

SUBSCRIBED AND SWORN TO before me this 12th day of November, 1963

Milton J. Volin
Notary Public.

My commission expires May 20, 1964



D R I L L E R I S L O G

15-185-60026-0000

Anschutz Drilling Company, Inc.
 J. Schulz
 NE NE NW - 20-235-137
 Stafford County, Kansas

FROM	TO	
0	100	Shale
100	170	Shale, sand & shells
170	233	Red shale & shells
233	298	Snad
298	320	Shale & shells
320	475	Red shale
475	765	Red bed
765	800	Anhydrite
800	870	Shale & shells
870	1200	Shale
1200	1260	Salt
1260	1600	Salt, shale & lime
1600	1700	Shale & shells
1700	1700	Lime & shale
1700	2040	Lime
2040	2100	Lime & shale
2100	2205	Shale & shells
2205	2305	Lime
2305	2565	Shale & lime
2565	2700	Shale
2700	2860	Shale & lime
2860	3355	Lime
3355	3425	Lime & shale
3425	3505	Shale
3505	3735	Lime
3735	3785	Lime & shale
3785	3824	Lime
3824	3858	Shale & lime
3858	3905	Viola chert
3905	3939	Lime & chert
3940	3980	Shale & lime
3980	4023	Lime
4023	4033	TOTAL DEPTH

COMMENCED: 5-20-52

COMPLETED: 6-11-52

CASING RECORD

Set 8-5/8" surface casing at 316 feet with 200 sacks cement and 2 sacks calcium chloride.
 Set 5-1/2" oil string at 3770 feet with 75 sacks cement.

ELEVATION: 1911.20

TOPS

Lansing 3512 (-1601)
 Conglomerate 3893
 Viola Chert 3958
 Arbuckle 3970

RECEIVED
 STATE CORPORATION COMMISSION

NOV 15 1963

CONSERVATION DIVISION
 Wichita, Kansas

STATE OF KANSAS
 COUNTY OF SEDGWICK

I hereby affirm that the foregoing is a true and correct of Anschutz Drilling Company, Inc., J. Schulz, located NE NE NW of Section 20-235-137, Stafford County, Kansas.

ANSCHUTZ DRILLING COMPANY, INC.

BY: *Leon L. Mehler*
 Leon L. Mehler

Subscribed and sworn to before me this 19th day of June, 1952.

Jacqueline L. ...
 Notary Public

My commission expires May 2, 1956