


Give All Information Completely
Make Required Affidavit
Mail or Deliver Report to:
Conservation Division
State Corporation Commission
212 No. Market
Wichita, Kansas

WELL PLUGGING RECORD 15-185-20524-0000

Stafford County, Sec. 23 Twp. 23S Rge. 13W ~~XXXXXX~~
Location as "NE/CNW/SW" or footage from lines C SE NE
Lease Owner Kansas Petroleum, Incorporated
Lease Name French Well No. 1
Office Address 500 Insurance Building, Wichita, Kansas 67202
Character of Well (completed as Oil, Gas or Dry Hole) Dry Hole
Date well completed August 28, 1974
Application for plugging filed August 28, 1974
Application for plugging approved August 28, 1974
Plugging commenced August 28, 1974
Plugging completed August 28, 1974
Reason for abandonment of well or producing formation Dry Hole.

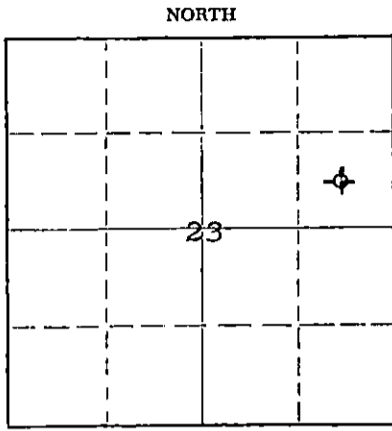

Locate well correctly on above Section Plat

If a producing well is abandoned, date of last production _____ 19____
Was permission obtained from the Conservation Division or its agents before plugging was commenced? Yes

Name of Conservation Agent who supervised plugging of this well _____
Producing formation _____ Depth to top _____ Bottom _____ Total Depth of Well 3480 Feet
Show depth and thickness of all water, oil and gas formations.

OIL, GAS OR WATER RECORDS

CASING RECORD

FORMATION	CONTENT	FROM	TO	SIZE	PUT IN	PULLED OUT
		0'	332'	8-5/8"	332'	None

Describe in detail the manner in which the well was plugged, indicating where the mud fluid was placed and the method or methods used in introducing it into the hole. If cement or other plugs were used, state the character of same and depth placed, from _____ feet to _____ feet for each plug set.

3480'-600' - Hole filled with mud & hulls,
600'-596' - Plug.
596'-300' - Cement, 30 sacks.
300'-296' - Plug.
296'-40' - Cement, 30 sacks.
40'-36' - Plug.
36'-6' - Cement, 13 sacks (Bottom of cellar)
2 sacks cement in rat hole.

RECEIVED
STATE CORPORATION COMMISSION
SEP 10 1974
CONSERVATION DIVISION
Wichita, Kansas

(If additional description is necessary, use BACK of this sheet)

Name of Plugging Contractor Halliburton Cementing Co.
Address Great Bend, Kansas

STATE OF KANSAS, COUNTY OF SEDGWICK, ss.
John D. Knightley Agent of Owner (owner or operator) of the above-described well, being first duly sworn on oath, says: That I have knowledge of the facts, statements, and matters herein contained and the log of the above-described well as filed and that the same are true and correct. So help me God.

(Signature) [Signature]
301 S. Broadway, Wichita, Kansas
(Address)

SUBSCRIBED AND SWORN TO before me this 4th day of September, 19 74

My commission expires March 12, 1975
Stella J. Lipps Notary Public.

Kansas Petroleum, Incorporated - French #1
C SE NE Sec. 23-23S-13W
Stafford County, Kansas

Contractor: D. R. Lauck Oil Company, Inc.
301 S. Broadway
Wichita, Kansas 67202

15-185-20524-0000

Commenced: August 21, 1974
Completed: August 29, 1974

Drillers Log

Sand	125
Shale & Sand	215
Sand	217
Shale & Red Bed	332
Shale	1075
Shale & Shells	1630
Lime & Shale	2980
Lime	3245
Lime & Shale	3480 RTD

RECEIVED
STATE CORPORATION COMMISSION
SEP 6 1974
CONSERVATION DIVISION
Wichita Kansas