


WELL PLUGGING RECORD

Give All Information Completely
Make Required Affidavit
Mail or Deliver Report to:
Conservation Division
State Corporation Commission
211 No. Broadway
Wichita, Kansas

Stafford County. Sec. 24 Twp. 23 Rge. (E) 13 (W)

Location as "NE/CNW/SW" or footage from lines NE NE NW
Lease Owner Stickle Drilling Company
Lease Name Smolik Well No. 1
Office Address 1027 Union Center, Wichita 2, Kansas
Character of Well (completed as Oil, Gas or Dry Hole) Dry Hole
Date well completed 28 July 1956
Application for plugging filed 28 July 1956
Application for plugging approved 28 July 1956
Plugging commenced 29 July 1956
Plugging completed 29 July 1956
Reason for abandonment of well or producing formation Dry Hole

NORTH

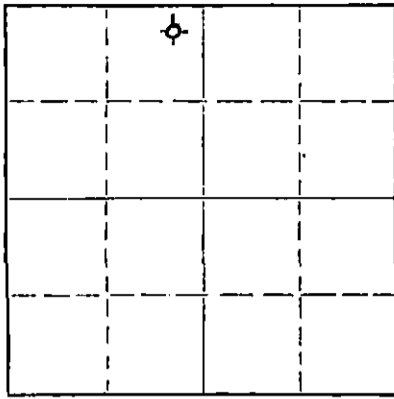

Locate well correctly on above Section Plat

If a producing well is abandoned, date of last production None 19
Was permission obtained from the Conservation Division or its agents before plugging was commenced? Yes

Name of Conservation Agent who supervised plugging of this well R.M. Brundage, Box 283, Hoisington, Kan.
Producing formation None Depth to top Bottom Total Depth of Well 3927 Feet
Show depth and thickness of all water, oil and gas formations.

OIL, GAS OR WATER RECORDS

CASING RECORD

FORMATION	CONTENT	FROM	TO	SIZE	PUT IN	PULLED OUT
Surface	Water	0	200	8 5/8	291	None

Describe in detail the manner in which the well was plugged, indicating where the mud fluid was placed and the method or methods used in introducing it into the hole. If cement or other plugs were used, state the character of same and depth placed, from feet to feet for each plug set.

Mixed mud in pits thoroughly with jets and placed heavy rotary mud from total depth to 210 feet through drill pipe placed on the bottom.

A Halliburton wood plug and 1/3 sack of hulls were placed at 210 feet with 20 sacks of cement placed on top of this through the drill pipe.

Heavy rotary mud was placed to 35 feet.

A Halliburton wood plug and 1/3 sack of hulls were placed at 35 feet with 10 sacks of cement placed on top through the drill pipe.

(If additional description is necessary, use BACK of this sheet)

Name of Plugging Contractor Stickle Drilling Company
Address 1027 Union Center, Wichita 2, Kansas

STATE OF Kansas, COUNTY OF Sedgwick, ss.
Clifford M. Smith (employee of owner) or (owner or operator) of the above-described well, being first duly sworn on oath, says: That I have knowledge of the facts, statements, and matters herein contained and the log of the above-described well as filed and that the same are true and correct. So help me God.

(Signature) Clifford M. Smith
1027 Union Center, Wichita 2, Kansas
(Address)

SUBSCRIBED AND SWORN to before me this 7th day of August 1956

My commission expires March 19, 1958

Reach Co. Jones
RECEIVED
Notary Public.
STATE CORPORATION COMMISSION
AUG 3 1956
8-3-56
CONSERVATION DIVISION
Wichita, Kansas

PLUGGING
FILE SEC 24 T. 23 R. 13w
BOOK PAGE 85 LINE 7

15-185-00915-0000

Stickle Drilling Company, et al
Tulsa, Oklahoma

Tulsa, Oklahoma
August 1, 1956

CONTRACTOR: Stickle Drilling Co.
Drilling Commenced: July 17, 1956
Drilling Completed: July 29, 1956

Smolik #1 - NE NE NW of
Section 24-23S-13W, Stafford
County, Kansas.

DRILLERS LOG

Depth Figures Indicate Base of Formation

Sand	160
Sand & Shale	220
Shale	291
Red Bed	715
Anhydrite	740
Shale & Shells	1550
Lime & Shale	2540
Shale & Lime	2935
Lime & Shale	3220
Lime	3312
Lime & Shale	3415
Lime	3680
Lime & Conglomerate	3756
Conglomerate	3761
Cherty Lime Viola	3800
Chert	3823
Lime	3851
Sand	3885
Simpson	3902
Arbuckle	3915
Lime	3927 TD

I, Frank E. Stickle, hereby certify the above to be a true and complete drillers log of Stickle Drilling Company, et al, Smolik #1, NE NE NW - Section 24-23S-13W, Stafford County, Kansas.

Frank E. Stickle
Frank E. Stickle

Lillian T. Bonham
Notary Public

February 13, 1960
My Commission Expires

PLUGS 3
FILE SEC. 24 T. 23 R. 13W
BOOK PAGE 85 LINE 7