


WELL PLUGGING RECORD

Give All Information Completely
Make Required Affidavit
Mail or Deliver Report to:
Conservation Division
State Corporation Commission
800 Bitting Building
Wichita, Kansas

NORTH

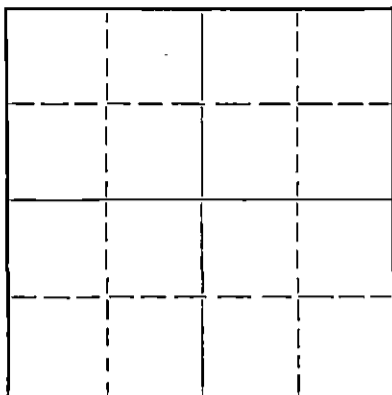

Locate well correctly on above
Section Plat

Stafford County. Sec 24 Twp. 23 Rge. (E) 13 (W)
Location as "NE/CNW $\frac{1}{4}$ SW $\frac{1}{4}$ " or footage from lines NE NE SW $\frac{1}{4}$
Lease Owner M. B. Armer
Lease Name Smolik Well No. 1
Office Address 710 Petroleum Building, Wichita, Kansas
Character of Well (completed as Oil, Gas or Dry Hole) dry
Date well completed 4/3 1952
Application for plugging filed 4/3 1952
Application for plugging approved 4/3 1952
Plugging commenced 4/3 1952
Plugging completed 4/3 1952
Reason for abandonment of well or producing formation dry

If a producing well is abandoned, date of last production 19...
Was permission obtained from the Conservation Division or its agents before plugging was commenced? YES

Name of Conservation Agent who supervised plugging of this well M. A. Rives
Producing formation Depth to top Bottom Total Depth of Well 3969 Feet
Show depth and thickness of all water, oil and gas formations.

OIL, GAS OR WATER RECORDS

CASING RECORD

Formation	Content	From	To	Size	Put In	Pulled Out
				8-5/8	294	none

Describe in detail the manner in which the well was plugged, indicating where the mud fluid was placed and the method or methods used in introducing it into the hole. If cement or other plugs were used, state the character of same and depth placed, from feet to feet for each plug set.

Filled hole with Rotary mud to 275 ft, set plug and ran 15 sacks cement through drill pipe. Filled with mud to 35 ft., set plug and ran 10 sacks cement for cap.

4-8-52

(If additional description is necessary, use BACK of this sheet)


Name of Plugging Contractor M. B. Armer
Address 710 Petroleum Building, Wichita, Kansas

STATE OF Kansas, COUNTY OF Sedgewick, ss.
L. L. Spunking (employee of owner) or (owner or operator) of the above-described well, being first duly sworn on oath, says: That I have knowledge of the facts, statements, and matters herein contained and the log of the above-described well as filed and that the same are true and correct. So help me God.
(Signature) L. L. Spunking
(Address)

SUBSCRIBED AND SWORN to before me this 7th day of April, 1952

My commission expires Sept. 17, 1955

Notary Public. (Signature)

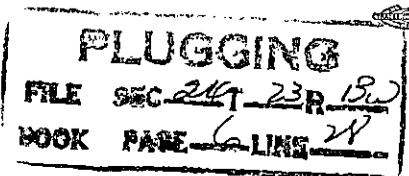

LOG

Company: Armer Drilling Company, Inc.
 Contractor: W. B. Armer (Idaco)
 Drilling Commenced: 3/23/52
 Drilling Completed: 4/3/52
 Elevation: 1881 R.S.
 1879 D.F.
 1876 Cr.

Farm: Saolik #1
 Location: NE 1/4 Sec. 24-23-13
 Stafford County, Kansas
 Casing Record: 8-5/8" casing at 291'
 with 275 sacks cement.

(figures below indicate bottoms)

Surface clay & sand	30
Sand, shale & shells	170
Sand & shale	215
Blue shale	245
Redbed	363
Shale & redbed	725
Anhydrite	755
Shale & redbed	1070
Shale & shells	1720
Shale & lime	1930
Shale, shells & sand	2100
Shale & lime	2360
Shale & lime shells	2575
Shale & lime	2783
Shale	2910
Shale & shells	3075
Shale & lime	3180
Lime, broken	3265
Lime	3325
Shale & lime	3410
Shale	3456
Lime	3715
Shale & lime	3788
Lime	3815
Lime & chert	3910
shale & lime	3920
Lime	3969
R.T.D	3969 D. & A.

FORMATION TOPS (R. B. Meas.)

Rebner	3292
Brown lime	3428
Lansing - Kansas City	3451
Cherty Viola	3788
Simpson	3858
Arbuckle	3918

I hereby certify that this is a true and correct log of the above described well as shown by the drilling reports.

W. B. ARMER

BY *[Signature]*

STATE OF KANSAS)

COUNTY OF SEDGWICK)

Subscribed and sworn to before me, a notary public, in and for said County and State this 14th day of April, 1952.

 Notary Public

My Commission expires Sept. 17, 1955.

PLUGGING
 FILE SEC 24-23-13
 BOOK PAGE 6 LINE 28