

15-185-00998-0000

STATE OF KANSAS
STATE CORPORATION COMMISSION


WELL PLUGGING RECORD

Give All Information Completely
Make Required Affidavit
Mail or Deliver Report to:
Conservation Division
State Corporation Commission
800 Bittling Building
Wichita, Kansas

Stafford County, Sec. 26 Twp. 23 Rge. 13 (E) (W)

Location as "NE/CNW $\frac{1}{4}$ /SW $\frac{1}{4}$ " or footage from lines SW SW NW
Lease Owner Musgrove Petroleum, Copr.
Lease Name Dunn Well No. 1
Office Address Wichita, Kansas
Character of Well (completed as Oil, Gas or Dry Hole) Dry Hole
Date well completed December 1, 19 50
Application for plugging filed December 1, 19 50
Application for plugging approved December 1, 19 50
Plugging commenced December 1, 19 50
Plugging completed December 1, 19 50
Reason for abandonment of well or producing formation

NORTH

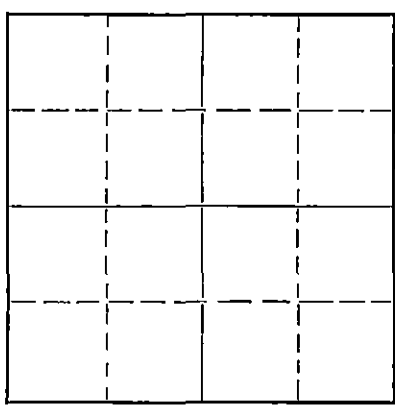

Locate well correctly on above
Section Plat

If a producing well is abandoned, date of last production 19
Was permission obtained from the Conservation Division or its agents before plugging was commenced? Yes

Name of Conservation Agent who supervised plugging of this well Mr. Staugh - Great Bend, Kansas
Producing formation Depth to top Bottom Total Depth of Well 3990 Feet
Show depth and thickness of all water, oil and gas formations.

OIL, GAS OR WATER RECORDS

CASING RECORD

Formation	Content	From	To	Size	Put In	Pulled Out
				8-5/8	310.91	Cemented w/ 175 sxs.

Describe in detail the manner in which the well was plugged, indicating where the mud fluid was placed and the method or methods used in introducing it into the hole. If cement or other plugs were used, state the character of same and depth placed, from feet to feet for each plug set.

Heavy mud to 300'
Bridge & Plug @ 300'
15 sxs. cement
Heavy mud to 30'
Bridge & Plug @ 30'
10 sxs. cement

12-6-50

RECEIVED
STATE CORPORATION COMMISSION
DEC 6 - 1950
CONSERVATION DIVISION
Wichita, Kansas

RECEIVED
STATE CORPORATION COMMISSION
DEC 4 - 1950
CONSERVATION DIVISION
Wichita, Kansas

(If additional description is necessary, use BACK of this sheet)
Correspondence regarding this well should be addressed to Stearns Drilling Co.
Address Russell, Kansas

STATE OF Kansas, COUNTY OF Russell, ss.
O. G. Stearns (employee of owner) or (owner or operator) of the above-described well,
being first duly sworn on oath, says: That I have knowledge of the facts, statements, and matters herein contained and the log of the above-described well as filed and that the same are true and correct. So help me God.

(Signature) Stearns Drilling Co. [Signature]

(Address)

SUBSCRIBED AND SWORN TO before me this 2nd day of December, 19 50

[Signature] Notary Public.

My commission expires June 20, 1953

23-3273-8 4-50-10M

PLUGGING
FILE SEC 26 T 23 R 13 W
BOOK PAGE 46 LINE 25

15-185-00998-0000

DUNN # 1

Commencement date: 11-17-50
Completion date: 12-1-50

Location: SW SW NW, 26-23-13,
Stafford County, Kansas.
Elevation: 1891' D. F.

Casing Record:
8-5/8" 308'

Totco:
30 min. 600'
30 min. 1100'
45 min. 1620'
45 min. 2100'
45 min. 2620'
1° 3000'

WELL LOG

sand	0	115
shale and shells	115	205
sand, shale and shells	205	308
red rock	308	755
<u>Anhydrite</u>	755	795
shale, shells and salt	795	1630
lime and shale	1630	2620
shale	2620	2970
shale and shells	2970	3000
lime and shale	3000	3279
lime	3279	3390
shale and lime	3390	3537
lime	3537	3823
cherty lime	3823	3841
<u>Viola lime</u>	3841	3938
<u>Top of Arbuckle</u>		3938
Total depth		3990

STATE OF KANSAS)
) SS
COUNTY OF RUSSELL)

RECEIVED
OIL AND GAS REGULATION COMMISSION
DEC 4 - 1950
CONSOLIDATION DIV.
Wichita, Kansas

I hereby certify that the above information is true and correct to the best of my knowledge.

[Signature]

Subscribed and sworn, before me this 2nd day of December, 1950.

[Signature]

NOTARY PUBLIC

MY COMMISSION EXPIRES: June 20 1953

PLUGGING
WELL SEC. 26 T. 23 R. 13W
BOOK PAGE 46 LINE 25