


WELL PLUGGING RECORD

Give All Information Completely
Make Required Affidavit
Mail or Deliver Report to:
Conservation Division
State Corporation Commission
800 Bitting Building
Wichita, Kansas

Stafford County, Sec. 27 Twp. 23 Rge. 13 (E) W (W)

Location as "NE/CNW&SW" or footage from lines NW NW SE
Lease Owner Lee Phillips Oil Co.
Lease Name Williams Well No. 1
Office Address 1407 Union National Bank Bldg., Wichita, Kansas
Character of Well (completed as Oil, Gas or Dry Hole) Dry Hole
Date well completed June 5 1956
Application for plugging filed June 5 1956
Application for plugging approved verbally June 5 1956
Plugging commenced June 5 1956
Plugging completed June 5 1956
Reason for abandonment of well or producing formation Dry Hole

NORTH

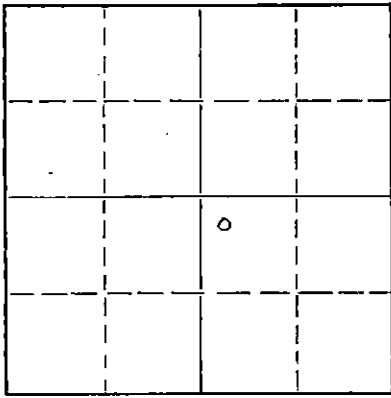

Locate well correctly on above Section Plat

If a producing well is abandoned, date of last production 19
Was permission obtained from the Conservation Division or its agents before plugging was commenced? yes

Name of Conservation Agent who supervised plugging of this well R. M. Brundage, Box 283, Hoisington, Kansas
Producing formation _____ Depth to top _____ Bottom _____ Total Depth of Well _____ Feet
Show depth and thickness of all water, oil and gas formations.

OIL, GAS OR WATER RECORDS

CASING RECORD

FORMATION	CONTENT	FROM	TO	SIZE	PUT IN	PULLED OUT
Surface		0	29 1/4'	8 5/8"	29 1/4'	none

Describe in detail the manner in which the well was plugged, indicating where the mud fluid was placed and the method or methods used in introducing it into the hole. If cement or other plugs were used, state the character of same and depth placed, from _____ feet to _____ feet for each plug set.

Filled hole with mud from total depth to 270' with plug set at 270' and 20 sacks of cement on plug. Filled with mud to 35' with plug set at 35' and 10 sacks of cement on plug.

(If additional description is necessary, use BACK of this sheet)

Name of Plugging Contractor Harms-Burt Drilling Co.
Address Box 184, Great Bend, Kansas

STATE OF KANSAS, COUNTY OF SEDGWICK, ss.
Nelle A. Salmon (employee of owner) or (owner or operator) of the above-described well, being first duly sworn on oath, says: That I have knowledge of the facts, statements, and matters herein contained and the log of the above-described well as filed and that the same are true and correct. So help me God.

(Signature) Nelle A. Salmon

(Address)

SUBSCRIBED AND SWORN TO before me this 13th day of June, 19 56

Elva L. Hanks

Elva L. Hanks Notary Public.

My commission expires June 10, 1959

PLUGGING
FILE SEC. 27 T. 23 R. 13W
BOOK PAGE 68 LINE 21

6-16-56

Driller's Log

15-185-00917-0000

Company: Lee Phillips Oil Co.
Farm: Williams No. 1

NW NW SE Section 27-23-13W
Stafford County, Kansas

Commenced: May 21, 1956

Completed: June 5, 1956

Elevation: 1896 KB

0 - 115	Sand	3306 - 3494	Lime & shale
115 - 175	Shale	3494 - 3575	Lime
175 - 294	Shale & sand	3575 - 3612	Lime & chert
294 - 306	Shale	3612 - 3707	Lime
306 - 745	Shale, sand, red bed	3707 - 3768	Lime & shale
745 - 763	Red bed	3768 - 3780	Lime & chert
763 - 790	Anhydrite	3780 - 3810	Lime
790 - 1635	Shale & shells	3810 - 3838	Conglomerate
1635 - 1675	Shale & lime	3838 - 3880	(Chert) Lime - shale
1675 - 2457	Lime & shale	3880 - 3909	Lime - shale
2457 - 2660	Shale & lime	3909 - 3916	Simpson
2660 - 2835	Lime & shale	3916 - 3938	Lime
2835 - 2945	Shale & lime	3938 - 3965	Lime
2945 - 3235	Lime & shale	3965	T. D.
3235 - 3306	Chalky lime & shale		

Set 294 feet of 8 5/8 inch surface pipe. Cemented with 250 sacks of common cement and 4 sacks of calcium chloride.

Tops: Anhydrite 763
Heebner 3468
Kansas City 3494
Simpson 3909
Arbuckle 3938

Drill Stem Tests: No. 1 3913 - 3916 Open 1 hr. Shut in 20 min.
Recovered 30 ft. oil, 330 ft. gas, 180 ft. oil & gas
cut water, 120 ft. salt water. BHP 1295#.

Dry, plugged and abandoned.

Affidavit: State of Kansas, County of Barton SS:
I, Allan Harms of Harms-Burt Drilling Company
being first duly sworn on oath state that I have knowledge
of the facts, statements, and matters herein contained
and the same are true and correct.
Signed Allan Harms
Subscribed and sworn to before me this 11 day of June 1956
Comm. Exp. 1-20-58
Mary E Van Celt
Notary Public

PLUGGING
FILE SEC 27 T23 R13W
BOOK PAGE 68 LINE 21