


STATE OF KANSAS
STATE CORPORATION COMMISSION

Give All Information Completely
Make Required Affidavit
Mail or Deliver Report to:
Conservation Division
State Corporation Commission
211 No. Broadway
Wichita, Kansas

WELL PLUGGING RECORD

Stafford County. Sec. 15 Twp. 22 Rge. 13 (~~E~~) W (W)
Location as "NE/CNW $\frac{1}{2}$ SW $\frac{1}{2}$ " or footage from lines N/2 SW NE
Lease Owner Woody's Quality Oil Company
Lease Name Soeken Well No. 5
Office Address 1119 Cravens Bldg., Oklahoma City, Oklahoma
Character of Well (completed as Oil, Gas or Dry Hole) Dry Hole
Date well completed 6-1-64 19
Application for plugging filed _____ 19
Application for plugging approved _____ 19
Plugging commenced 6-1-64 19
Plugging completed 6-1-64 19
Reason for abandonment of well or producing formation Dry Hole

NORTH

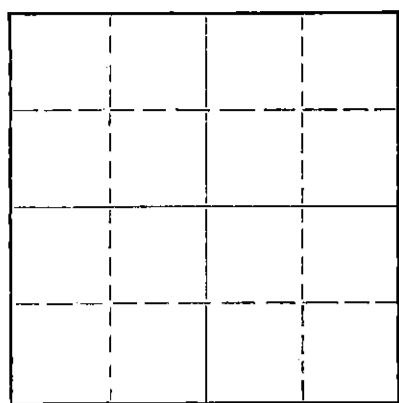

Locate well correctly on above
Section Plat

If a producing well is abandoned, date of last production _____ 19
Was permission obtained from the Conservation Division or its agents before plugging was commenced? _____

Name of Conservation Agent who supervised plugging of this well Archie Elving
Producing formation _____ Depth to top _____ Bottom _____ Total Depth of Well 3840 Feet
Show depth and thickness of all water, oil and gas formations.

OIL, GAS OR WATER RECORDS

CASING RECORD

FORMATION	CONTENT	FROM	TO	SIZE	PUT IN	PULLED OUT

Describe in detail the manner in which the well was plugged, indicating where the mud fluid was placed and the method or methods used in introducing it into the hole. If cement or other plugs were used, state the character of same and depth placed, from _____ feet to _____ feet for each plug set.

Set plug at 280', $\frac{1}{4}$ sack hulls and 25 sacks cement through drill pipe. Filled hole with heavy mud. Set plug at 40', $\frac{1}{4}$ sack hulls and 10 sacks cement. Plugged rat hole with 4 sacks cement.

RECEIVED
STATE CORPORATION COMMISSION
JUL 22 1964
7-22-64
CONSERVATION DIVISION
Wichita, Kansas

(If additional description is necessary, use BACK of this sheet)

Name of Plugging Contractor _____
Address _____

STATE OF Kansas, COUNTY OF Barton, ss.
L. O. Chubb contractor (~~employee of owner~~) for (owner or operator) of the above-described well, being first duly sworn on oath, says: That I have knowledge of the facts, statements, and matters herein contained and the log of the above-described well as filed and that the same are true and correct. So help me God.

(Signature) [Signature]
Box 823, Great Bend, Kansas
(Address)

SUBSCRIBED AND SWORN TO before me this 20th day of July, 19 64

My commission expires 6-24-67
Clair E. Stimson Notary Public.



W E L L L O G

Date Commenced: May 17, 1964
 Date Completed: June 1, 1964

Woody's Quality Oil Company
 SOEKEN #5
 N/2 SW NE Sec. 15-22S-13W
 Stafford County, Kansas

0	-	40	Clay-Sand
40	-	250	Sand-Shale
250	-	451	Red Bend - Shale
451	-	482	Anhydrite
482	-	750	Red Bed
750	-	1102	Shale-Shells
1102	-	1304	Salt-Shale
1304	-	1551	Shale - Shells
1551	-	2082	Lime-Shale
2082	-	2500	Shale-Lime
2500	-	2864	Lime - Shale
2864	-	3254	Lime
3254	-	3259	Shale
3259	-	3290	Lime-Shale
3290	-	3384	Shale
3384	-	3404	Brown Lime-Shale
3404	-	3640	Lime
3640	-	3705	Conglomerate
3705	-	3764	Chert
3764	-	3813	Shale
3813	-	3846	Dolomite

ELEVATION: 1896 K.B.
 1888 G.L.

FORMATION DATA E Log

Heebner	3254
Douglas	3290
Brown Lime	3384
Lansing	3404
Viola	3705
Simpson	3764
Arbuckle	3813
R.T.D.	3840

SURFACE CASING: Set: 8 5/8"
 at 298' with 250 sacks cement.

RECEIVED
 STATE CORPORATION COMMISSION

JUL 22 1964

A F F I D A V I T

STATE OF KANSAS
 COUNTY OF BARTON)ss.

CONSERVATION DIVISION
 Wichita, Kansas

L. O. Chubb, of lawful age, does swear that the facts and statements herein contained are true and correct to the best of his knowledge.


 L. O. Chubb

Subscribed and sworn to before me this 20 day of July, 1964.

My Commission Expires:

June 24, 1967


 Clair E. Stinson-Notary Public