


WELL PLUGGING RECORD

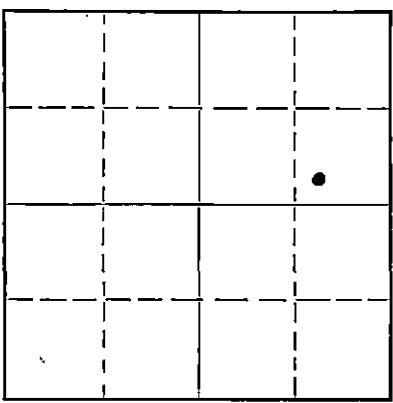

Locate well correctly on above Section Plat

Stafford County. Sec. 15 Twp. 22 Rge. 13 (E) W (W)
 Location as "NE/CNW $\frac{1}{4}$ SW $\frac{1}{4}$ " or footage from lines SW-SE-NE
 Lease Owner PETROLEUM, Inc.
 Lease Name Soeken "B" Well No. 1
 Office Address 305 East Third Street, Wichita, Kansas
 Character of Well (completed as Oil, Gas or Dry Hole) Oil
 Date well completed September 4 19 52
 Application for plugging filed April 22 19 53
 Application for plugging approved May 14 19 53
 Plugging commenced May 14 19 53
 Plugging completed May 19 19 53
 Reason for abandonment of well or producing formation Depleted Producing zones
 If a producing well is abandoned, date of last production April 16 19 53
 Was permission obtained from the Conservation Division or its agents before plugging was commenced? yes

Name of Conservation Agent who supervised plugging of this well Mr. Merle Rives
 Producing formation Arbuckle Depth to top 3,786' Bottom -- Total Depth of Well 3,794' Feet
 Show depth and thickness of all water, oil and gas formations.

OIL, GAS OR WATER RECORDS

CASING RECORD

Formation	Content	From	To	Size	Put In	Pulled Out
Arbuckle	Oil	3,787'	3,789'	8-5/8"	290'	None
				5-1/2"	3,787'	3,159'

Describe in detail the manner in which the well was plugged, indicating where the mud fluid was placed and the method or methods used in introducing it into the hole. If cement or other plugs were used, state the character of same and depth placed, from feet to feet for each plug set.

Filled hole with crushed rock from 3,794 to 3,775', and mudded up to 270' and placed rock bridge at 270'. Ran 20 sacks cement on to rock bridge at 270' and mudded up to 35'. Ran 10 sacks cement filling hole from 35' to base of well cellar.

6-16-53

(If additional description is necessary, use BACK of this sheet)


Correspondence regarding this well should be addressed to PETROLEUM, Inc.
 Address Rural Route 2, Great Bend, Kansas

STATE OF Kansas, COUNTY OF Sedgewick, ss.
 (employee of owner) or (owner or operator) of the above-described well,
 being first duly sworn on oath, says: That I have knowledge of the facts, statements, and matters herein contained and the log of the above-described well as filed and that the same are true and correct. So help me God.
 (Signature) Paul B. Oliver
 Rural Route 2, Great Bend, Kansas
 (Address)

SUBSCRIBED AND SWORN TO before me this 4th day of June, 19 53.

My Commission Expires Oct. 13, 1954

Charlotte Heidman
 Notary Public.

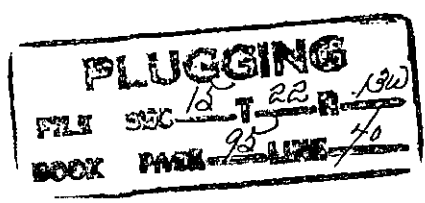

DRILLER'S LOG SOEKEN 'B' #1

Petroleum, Inc., Operator
 Garvey Drilling Company, Contractor
 Drilling Commenced: August 18, 1952
 Drilling Completed: August 29, 1952
 Casing Record: 8 5/8" @ 290' w/175 sax
 5 1/2" @ 3787' w/50 sax

Section 15, Twp. 22S, Rge. 13W
 Location: SW SE NE
 County: Stafford County, Kansas
 R.T.D.: 3790'
 Production: Arbuckle

Figures below indicate bottom of formations:

40 Surface soil
 240 Sand and Gravel
 740 Red Bed & Shells
 773 Anhydrite
 1500 Shale & Shells
 3015 Shale & Lime
 3085 Lime
 3192 Lime & Shale
 3245 Lime
 3378 Lime & Shale
 3655 Lime
 3669 Shale & Lime
 3707 Chert
 3733 Viola Chert
 3743 Simpson shale
 3790 Shale & Lime

Tops:

Heebner: 3247 (-1351)
 Brown Lime: 3378 (-1482)
 Lansing: 3398 (-1502)
 Conglomerate: 3669 (-1773)
 Simpson: 3723 (-1827)
 Arbuckle: 3786 (-1890)

DST #1, 3420-70, open 45 mins., rec. 15' mud,
 0# BHP.
 DST #2, 3512-3543, open 30 mins., rec. 10' mud,
 0# bhp.
 DST #3, 3545-90, open 45 mins., rec. 20' mud,
 400# BHP.
 DST #4, 3787-90, open 1 hr., rec. 350' gas, 430'
 gassy oil, BHP 460#.

3790' R.T.D.

I hereby certify that this is a true and correct log of the above mentioned well.

PETROLEUM, INC.

By W. W. Fisher

STATE OF KANSAS)
) SS:
 COUNTY OF SEDGWICK)

Subscribed to and sworn to before me, a Notary Public, in said County and State, this 4th day of September, 1952.

Charles H. Jones
 Notary Public

My commission expires: October 13, 1954.

JUN 15 1952

PLUGGING
 FILE SEC 15 T 22 R 13W
 BOOK PAGE 95 LINE 40