

WELL PLUGGING RECORD


Give All Information Completely
Make Required Affidavit
Mail or Deliver Report to:
Conservation Division
State Corporation Commission
211 No. Broadway
Wichita, Kansas

Stafford

County. Sec. 13 Twp. 22S Rge. 13 (W)

Location as "NE/CNW/SW" or footage from lines C N/2 N/2 SE/4
Lease Owner Petroleum Operating Company
Lease Name Teichmann Well No. 1
Office Address P. O. Box 7027, Tulsa, Oklahoma
Character of Well (completed as Oil, Gas or Dry Hole) dry hole
Date well completed 10-5 19 62
Application for plugging filed 10-5 19 62
Application for plugging approved 10-5 19 62
Plugging commenced 10-5 19 62
Plugging completed 10-5 19 62
Reason for abandonment of well or producing formation dry hole

NORTH

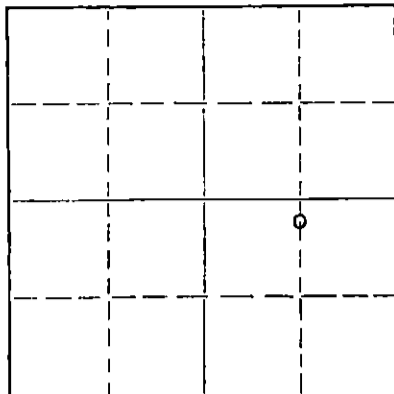

Locate well correctly on above Section Plat

If a producing well is abandoned, date of last production 19
Was permission obtained from the Conservation Division or its agents before plugging was commenced? yes

Name of Conservation Agent who supervised plugging of this well W. L. Lackamp
Producing formation Depth to top Bottom Total Depth of Well 3721 Feet
Show depth and thickness of all water, oil and gas formations.

OIL, GAS OR WATER RECORDS

CASING RECORD

Table with 7 columns: FORMATION, CONTENT, FROM, TO, SIZE, PUT IN, PULLED OUT. Rows include Lansing, Conglomerate, Viola, Simpson, and Arbuckle.

Describe in detail the manner in which the well was plugged, indicating where the mud fluid was placed and the method or methods used in introducing it into the hole. If cement or other plugs were used, state the character of same and depth placed, from feet to feet for each plug set.

Bottom plug @ 240' w/20 cement
Top plug @ 35' w/10 cement

RECEIVED
STATE CORPORATION COMMISSION
OCT 15 1962
CONSERVATION DIVISION
Wichita, Kansas

10-15-62

(If additional description is necessary, use BACK of this sheet)

Name of Plugging Contractor Rotary well drilled - no pipe set.
Address

STATE OF OKLAHOMA, COUNTY OF TULSA, ss.
Joseph Teichman (employee of owner) or (owner or operator) of the above-described well, being first duly sworn on oath, says: That I have knowledge of the facts, statements, and matters herein contained and the log of the above-described well as filed and that the same are true and correct. So help me God.

(Signature) Joseph Teichman
Box 7027, Tulsa, Okla. (Address)

SUBSCRIBED AND SWORN TO before me this 12th day of October, 19 62

My commission expires 3-17-64

Notary Public



SHOLOM DRILLING COMPANY, INC.
 P. O. Box 7027
 Tulsa, Oklahoma

FORMATION LOG

COMPANY: Petroleum Operating Company
 FARM: Teichmann
 LOCATION: C N/2 N/2 SE Sec. 13 T22S R13W - Stafford County, Kansas
 ROTARY DRILLING CONTRACTOR: Sholom Drilling Company, Inc.

COMMENCED: 9-25-62
 COMPLETED: 10-5-62
 I. P.: D & A

Elevation: 1892' K.B.
 Rotary TD: 3721'

Casing Record:
 8-5/8" @ 254' w/190 sax

L O G

0	-	225	Clay & Sand
225	-	233	Clay
233	-	254	Plug & Cement
254	-	721	Red Bed
721	-	746	Anhydrite
746	-	1470	Shale & Shells
1470	-	3015	Lime & Shale
3015	-	3190	Lime
3190	-	3395	Lime & Shale
3395	-	3560	Lime
3560	-	3645	Lime, Shale & Chert
3645	-	3669	Cong.
3669	-	3692	Shale & Sand
3692	-	3714	Shale
3714	-	3721	Arbuckle

DST #1 3331-3400
 Rec. 190' drilling mud.
 DST #2 3399-3460
 Rec. 480' watery drilling mud.
 DST #3 3460-3560
 Rec. 60' gas, 60' slightly oil specked mud.
 DST #4 3659-3692
 Rec. 75' watery drilling mud with a few specks of oil.
 DST #5 3711-3721
 Rec. 485' sulfur water

Anhydrite	721-46 (driller)
Heebner	3194'
Brown Lime	3327'
Lansing	3337'
Base of Kansas City	3580'
Marmaton	3587'
Conglomerate	3597'
Viola	3619'
Simpson Shale	3661'
Simpson Sandstone	3684-91'
Arbuckle	3710'

RECEIVED
 STATE CORPORATION COMMISSION
 OCT 15 1962
 CONSERVATION DIVISION
 Wichita, Kansas

STATE OF OKLAHOMA)
) ss.
 COUNTY OF TULSA)

I, Joseph Teichman, President of Sholom Drilling Company, Inc. a corporation of the State of Oklahoma, domesticated in the State of Kansas, being first duly sworn under oath, says: That I have knowledge of the facts, statements and matters herein contained of the above described well as filed and that the same are true and correct.

Joseph Teichman

 Joseph Teichman

Subscribed and sworn to before me this 12th day of October, 1962.

W. H. Hunter

 Notary Public

My commission expires: 3-17-64