


STATE OF KANSAS  
STATE CORPORATION COMMISSION

WELL PLUGGING RECORD

Give All Information Completely.  
Make Required Affidavit  
Mail or Deliver Report to:  
Conservation Division  
State Corporation Commission  
212 W. Market  
Wichita, Kansas

Stafford County, Sec. 15 Twp. 22 Rge. 13 (E) (W) X

Location as "NE/CNW/SW" or footage from lines SW SE NE  
Lease Owner Sooner Pipe & Supply Co.  
Lease Name Soeken "B" Well No. #3  
Office Address 301 Petroleum Club Bldg. Tulsa, Oklahoma  
Character of Well (completed as Oil, Gas or Dry Hole)  
Date well completed 19  
Application for plugging filed 5-9-67 19  
Application for plugging approved 19  
Plugging commenced 7-10-67 19  
Plugging completed 7-13-67 19  
Reason for abandonment of well or producing formation

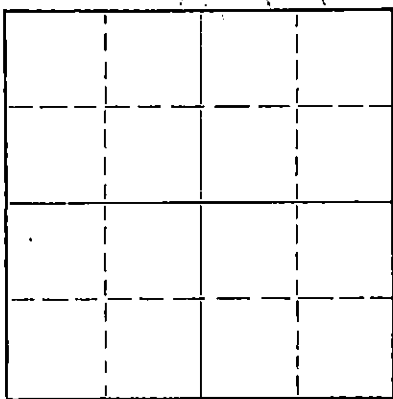

Locate well correctly on above Section Plat

If a producing well is abandoned, date of last production 19  
Was permission obtained from the Conservation Division or its agents before plugging was commenced?

Name of Conservation Agent who supervised plugging of this well Archie Elving  
Producing formation Depth to top Bottom Total Depth of Well 3909' Feet  
Show depth and thickness of all water, oil and gas formations.

OIL, GAS OR WATER RECORDS

CASING RECORD

FORMATION	CONTENT	FROM	TO	SIZE	PUT IN	PULLED OUT
				4 1/2"	3909'	2930.90'
				8 5/8"	270'	

Describe in detail the manner in which the well was plugged, indicating where the mud fluid was placed and the method or methods used in introducing it into the hole. If cement or other plugs were used, state the character of same and depth placed, from feet to feet for each plug set.

Made bottom hole plug back with sand to 3700', mixed and ran 4 sacks cement thru dump bailer.  
Mudded hole to 260', set 10' rock bridge. Mixed and ran 1 sack calseal and 1 sack cement thru dump bailer. Filled hole with 3 1/4 hards ready-mix from 245' to base of cellar.

7-17-67

RECEIVED  
STATE CORPORATION COMMISSION

JUL 17 1967


CONSERVATION DIVISION  
Wichita, Kansas

Name of Plugging Contractor Southwest Casing Pulling Co., Inc.  
Address Box 364, Great Bend, Kansas

STATE OF Kansas, COUNTY OF Barton, ss.  
Southwest Casing Pulling Co., Inc. (employee of owner) or (owner or operator) of the above-described well, being first duly sworn on oath, says: That I have knowledge of the facts, statements, and matters herein contained and the log of the above-described well as filed and that the same are true and correct. So help me God.

(Signature) W. C. Spencer Sec.  
Box 364, Great Bend, Kansas (Address)

SUBSCRIBED and sworn to before me this 15 day of July, 19 67

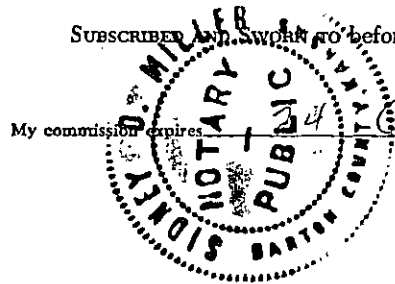

October 1968

Sidney D. Miller  
Notary Public.

JUL 5 1967

CONSERVATION DIVISION  
Wichita, KansasW E L L    L O GDate Commenced: February 24, 1964  
Date Completed: March 4, 1964WOODY'S QUALITY OIL COMPANY  
SOEKEN #3  
SW SE NE Sec. 15-22-13W  
Stafford County, Kansas

ELEVATION        1894 K.B.

0	-	255'	Clay & Sand
255	-	744'	Red Bed
744	-	773'	ANHYDRITE
773	-	1590'	Shale, Shells-Salt
1590	-	2045'	Shale - Lime
2045	-	2854'	Lime & Shale
2854	-	3244'	Lime
3244	-	3264'	Shale & Lime
3264	-	3280'	Lime
3280	-	3374'	Shale
3374	-	3604'	Lime
3604	-	3692'	Lime - Shale
3692	-	3732'	Chert
3732	-	3788'	Shale
3788	-	3910'	Dolomite

## FORMATION DATA:

ANHYDRITE	744-773'
HEEBNER	3244
BROWN LIME	3374
LANSING	3396
VIOLA	3691
ARBUCKLE	3788
RTD	3910

SURFACE CASING: Set: 11 Jts.  
new & used 8-5/8" pipe tally  
260.89' @ 268' with 400 sacks  
cement.PRODUCTION CASING: Set: 123 jts  
new 4 1/2" 9.5# casing, tally thds.  
off 3914.96' at 3909' with 200  
sacks pozmix.A F F I D A V I TSTATE OF KANSAS  
COUNTY OF BARTON ) ss.

L. O. Chubb, of lawful age, does swear that the facts and statements herein contained are true and correct to the best of his knowledge.

  
 \_\_\_\_\_  
 L. O. Chubb
Subscribed and sworn to before me this 5th day of March, 1964.My Commission Expires:  
June 24, 1967
  
 \_\_\_\_\_  
 Clair E. Stinson-NOTARY PUBLIC