

22339

185-22, 239-0000

STATE CORPORATION COMMISSION OF KANSAS
OIL & GAS CONSERVATION DIVISION

WELL COMPLETION OR RECOMPLETION FORM
ACO-1 WELL HISTORY

DESCRIPTION OF WELL AND LEASE

Operator: License # 8376
Name Striker Petroleum Corporation
Address 5690 DTC Boulevard
Suite 410
City/State/Zip Englewood, CO 80111

Purchaser: Inland Purchasing & Transportation

Operator Contact Person Kevin Tracy
Phone (303) 694-3220

Contractor: License # 5927
Name Blackstone Drilling, Inc.

Wellsite Geologist Ben Landes
Phone (316) 262-5061

Designate Type of Completion

- New Well Re-Entry Workover
- Oil SWD Temp Abd
- Gas Inj Delayed Comp.
- Dry Other (Core, Water Supply etc.)

If OWWO: old well info as follows:

Operator
Well Name
Comp. Date
Old Total Depth

WELL HISTORY

Drilling Method:

- Mud Rotary Air Rotary Cable

2/18/86 2/23/86 2/23/86
Spud Date Date Reached TD Completion Date

3726
Total Depth PBTD

Amount of Surface Pipe Set and Cemented at 219 feet
Multiple Stage Cementing Collar Used? Yes No

If yes, show depth set... feet
If alternate 2 completion, cement circulated from... feet depth to... w/... SX cmt

API NO. 15-
County Stafford
W/2 SE SE Sec. 12. Twp. 24 Rge. 11


660 Ft North from Southeast Corner of Section
990 Ft West from Southeast Corner of Section
(Note: Locate well in section plat below)

Lease Name Zenith Waterflood Unit Well # 34
Field Name Zenith-Peace Creek

Producing Formation Misener

Elevation: Ground 1795 KB 1799

Section Plat

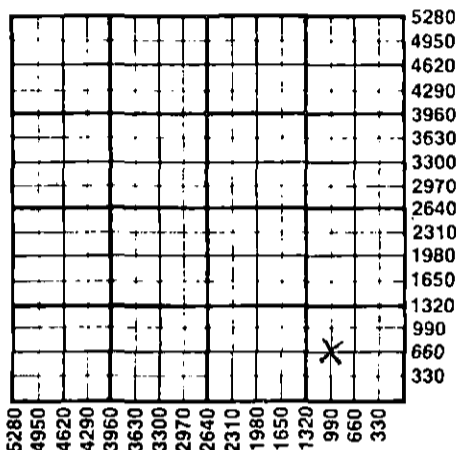

WATER SUPPLY INFORMATION

Disposition of Produced Water: Disposal
Docket # E-12893 Repressuring

Questions on this portion of the ACO-1 call:
Water Resources Board (913) 296-3717

Source of Water:
Division of Water Resources Permit #

- Groundwater... Ft North from Southeast Corner (Well) ... Ft West from Southeast Corner of Sec Twp Rge East West
- Surface Water... Ft North from Southeast Corner (Stream, pond etc)... Ft West from Southeast Corner Sec Twp Rge East West
- Other (explain) (purchased from city, R.W.D. #)

INSTRUCTIONS: This form shall be completed in duplicate and filed with the Kansas Corporation Commission, 200 Colorado Derby Building, Wichita, Kansas 67202, within 90 days after completion or recompletion of any well, Rule 82-3-130 and 82-3-107 apply. Information on side two of this form will be held confidential for a period of 12 months if requested in writing and submitted with the form. See rule 82-3-107 for confidentiality in excess of 12 months. One copy of all wireline logs and drillers time log shall be attached with this form. Submit CP-4 form with all plugged wells. Submit CP-111 form with all temporarily abandoned wells.

All requirements of the statutes, rules and regulations promulgated to regulate the oil and gas industry have been fully complied with and the statements herein are complete and correct to the best of my knowledge.

Signature Kevin J. Tracy
Title Manager of Production & Engineering date 5/12/86

Subscribed and sworn to before me this 12th day of May 1986
Notary Public Carol M. Aniello

Date Commission Expires 2-21-88

CAROL M. ANIELLO
1426 S. RACE ST.
DENVER, COLO. 80210

RECEIVED
STATE CORPORATION COMMISSION
MAY 14 1986
CONSERVATION DIVISION
Wichita, Kansas

K.C.C. OFFICE USE ONLY
F Letter of Confidentiality Attached
C Wireline Log Received
C Drillers Timelog Received
Distribution
 KCC SWD/Rep NGPA
 KGS Plug Other
(Specify)

Form ACO-1 (7-84)

5-11-86

Sec 12, Twp 24, Rge 11

Operator Name Striker Petroleum Corporation Lease Name Zenith Unit Well # 34

Sec. 12 Twp. 24 Rge. 11 East West County Stafford

WELL LOG

INSTRUCTIONS: Show important tops and base of formations penetrated. Detail all cores. Report all drill stem tests giving interval tested, time tool open and closed, flowing and shut-in pressures, whether shut-in pressure reached static level, hydrostatic pressures, bottom hole temperature, fluid recovery, and flow rates if gas to surface during test. Attach extra sheet if more space is needed. Attach copy of log.

Drill Stem Tests Taken Yes No
 Samples Sent to Geological Survey Yes No
 Cores Taken Yes No

Formation Description
 Log Sample

Name	Top	Bottom
Misener	3729	3732

CASING RECORD <input checked="" type="checkbox"/> New <input type="checkbox"/> Used							
Report all strings set-conductor, surface, intermediate, production, etc.							
Purpose of String	Size Hole Drilled	Size Casing Set (In O.D.)	Weight Lbs/Ft.	Setting Depth	Type of Cement	#Sacks Used	Type and Percent Additives
Surface.....	12 1/4	8 5/8	23	219	CIA	175	3% CaCl ₂
Production.....	7 7/8	5 1/2	15.5	3725	RFC	125	
PERFORATION RECORD				Acid, Fracture, Shot, Cement Squeeze Record			
Shots Per Foot	Specify Footage of Each Interval Perforated			Amount and Kind of Material Used			Depth
				500 gal. 15% HCl			3725-3732
				Frac. 2000 lb. 20-40 sd			3725-3732
TUBING RECORD				Liner Run	<input type="checkbox"/> Yes <input checked="" type="checkbox"/> No		
Size	Set At	Packer at					
2 7/8	3633						
Date of First Production	Producing Method						
April 22, 1986	<input type="checkbox"/> Flowing <input checked="" type="checkbox"/> Pumping <input type="checkbox"/> Gas Lift <input type="checkbox"/> Other (explain).....						
Estimated Production Per 24 Hours	Oil	Gas	Water	Gas-Oil Ratio	Gravity		
	24 Bbls	MCF	580 Bbls	CFPB	40		

METHOD OF COMPLETION

Production Interval

Disposition of gas: Vented Open Hole Perforation
 Sold Other (Specify)
 Used on Lease Dually Completed Commingled

3725-3732

