

Exp. 12-6-84
CARD MUST BE TYPED

State of Kansas
NOTICE OF INTENTION TO DRILL

(see rules on reverse side)

15-185-22023-0000

Correction
CARD MUST BE SIGNED
2-11-84

Starting Date: 7 14 84
month day year

OPERATOR: License # 7702

Name .. STALCUP OIL COMPANY

Address 3511 23rd Street

City/State/Zip Great Bend, Kansas 67530

Contact Person .. Ralph Stalcup

Phone 316/793-3118

CONTRACTOR: License # 5864

Name .. LDBO DRILLING CO., INC.

City/State Great Bend, Kansas 67530

Well Drilled For: Well Class: Type Equipment:

- Oil Swd Infield Mud Rotary
- Gas Inj Pool Ext. Air Rotary
- OWWO Expl Wildcat Cable

If OWWO: old well info as follows:

Operator

Well Name

Comp Date Old Total Depth

Projected Total Depth 3700 feet

Projected Formation at TD Arbuckle

Expected Producing Formations Arbuckle

I certify that we will comply with K.S.A. 55-101, et seq., plus eventually plugging hole to K.C.C. specifications.

Date 7/11/84 Signature of Operator or Agent

Sally R. Byers

Title Agent

"CORRECTION"

API Number 15- 185-22,023

C-N/2 NW SW

..... Sec. 11. Twp. 22. S. Rge. 13. ...
(location) East West

* 2310 Ft North from Southeast Corner of Section

* 4620 Ft West from Southeast Corner of Section

(Note: Locate well on Section Plat on reverse side)

Nearest lease or unit boundary line 330 feet.

County Stafford

Lease Name Sittner Well# 6

Domestic well within 330 feet : yes no

Municipal well within one mile : yes no

Depth to Bottom of fresh water 112 feet

Lowest usable water formation Top of Permian

Depth to Bottom of usable water .. 250 feet

Surface pipe by Alternate : 1 2

Surface pipe to be set 300 feet

Conductor pipe if any required feet

Ground surface elevation feet MSL

This Authorization Expires 12-6-84

Approved By *E/6/84*


*was. NE NW SW
990FWL*

Must be filed with the K.C.C. five (5) days prior to commencing well
 This card void if drilling not started within six (6) months of date received by K.C.C.

RECEIVED
 STATE CORPORATION COMMISSION

Important procedures to follow: **July 11 1984**

A Regular Section of Land
 1 Mile = 5,280 Ft.

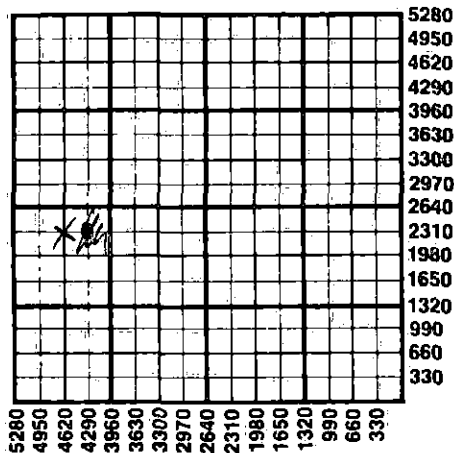

- CONSERVATION DIVISION
 Wichita, Kansas
- 7-11-84
1. Notify District office before setting surface casing.
 2. Set surface casing by circulating cement to the top.
 3. File completion forms ACO-1 with K.C.C. within 90 days of well completion, following instructions on ACO-1, side 1, and including copies of wireline logs.
 4. Notify District office 48 hours prior to old well workover or re-entry.
 5. Prior to plugging, prepare a plugging plan, then obtain agreement from the appropriate district office for an approved plugging plan.
 6. Submit plugging report (CP-4) to K.C.C. after plugging is completed.
 7. Obtain an approved injection docket number before disposing of salt water.
 8. Notify K.C.C. within 10 days when injection commences or terminates.
 9. If an alternate 2 completion, cement in the production pipe from below any usable water to surface within 120 days of spud date.

State Corporation Commission of Kansas
 Conservation Division
 200 Colorado Derby Building
 Wichita, Kansas 67202
 (316) 263-3238