


STATE OF KANSAS
STATE CORPORATION COMMISSION

Give All Information Completely
Make Required Affidavit
Mail or Deliver Report to:
Conservation Division
State Corporation Commission
800 Bitting Building
Wichita, Kansas

WELL PLUGGING RECORD

NORTH

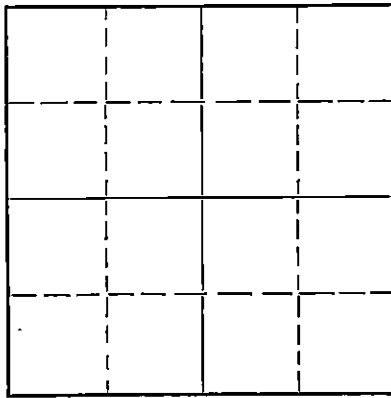

Locate well correctly on above
Section Plat

Stafford County. Sec. 2 Twp. 22 Rge. 13 NE (W)
Location as "NE/CNW/SW" or footage from lines NE NW NW
Lease Owner Womer Investment Company
Lease Name Batman Well No. 2
Office Address 518 Petroleum Building, Wichita, Kans.
Character of Well (completed as Oil, Gas or Dry Hole) dry hole
Date well completed January 17, 1954 19 54
Application for plugging filed Verbally - January 16, 1954 19 54
Application for plugging approved " 1-16-54 - written Jan 19, 19 54
Plugging commenced January 17, 1954 19 54
Plugging completed January 17, 1954 19 54
Reason for abandonment of well or producing formation dry hole

If a producing well is abandoned, date of last production _____ 19____
Was permission obtained from the Conservation Division or its agents before plugging was commenced? Yes - verbally

Name of Conservation Agent who supervised plugging of this well Warren H. Horner, Box 207, Great Bend, Ks.
Producing formation _____ Depth to top _____ Bottom _____ Total Depth of Well 3760 Feet
Show depth and thickness of all water, oil and gas formations.

OIL, GAS OR WATER RECORDS

CASING RECORD

FORMATION	CONTENT	FROM	TO	SIZE	PUT IN	PULLED OUT
				8-5/8"	289'	

Describe in detail the manner in which the well was plugged, indicating where the mud fluid was placed and the method or methods used in introducing it into the hole. If cement or other plugs were used, state the character of same and depth placed, from _____ feet to _____ feet for each plug set.

Filled hole with heavy mud to 270'. Set first plug with 1/3 sack hulls and 20 sacks cement. Filled hole with mud to 35'. Set second plug with 1/3 sack hulls and 10 sacks cement.

1-21-54

(If additional description is necessary, use BACK of this sheet)

Name of Plugging Contractor Misgrove Petroleum Corporation,
Address 518 Petroleum Building, Wichita, Kansas.


STATE OF Kansas, COUNTY OF Sedgwick, ss.
L. Gordon L. Koelling (employee of owner) or (owner or operator) of the above-described well, being first duly sworn on oath, says: That I have knowledge of the facts, statements, and matters herein contained and the log of the above-described well as filed and that the same are true and correct. So help me God.

(Signature) Gordon L. Koelling
518 Petroleum Building, Wichita, Kansas.
(Address)

SUBSCRIBED AND SWORN TO before me this 20th day of January, 19 54

My commission expires September 24, 1956.

Helena L. Stumpe
Notary Public.

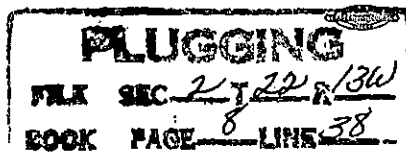

CONTRACTOR'S WELL LOG

COMPANY: Womer Investment Company
 CONTRACTOR: Musgrove Petroleum Corporation
 FARM: Batman #2
 LOCATION: NE NW NW, Section 2-22-13,
 Stafford County, Kansas
 COMMENCED: January 7, 1954
 COMPLETED: January 17, 1954

0	250	Sand and shale
250	291	Red rock
291	650	Red bed & sand
650	1075	Bl. shale, chat & shells
1075	1650	Shale & shells
1650	2150	Lime & shale
2150	2185	Shale & lime shells
2185	2515	Shale & lime
2515	2670	Shale & lime shells
2670	2725	Shale & lime breaks
2725	2740	Shale & lime shells.
2740	3335	Lime & shale
3335	3410	Lime
3410	3530	Lime & shale
3530	3556	Lime
3556	3600	Lime & shale.
3600	3665	Lime, chert & shale
3665	3712	Lime, chert & shale (Simpson)
3712	3760	Arbuckle
	3760	Rotary Total Depth

Set 8-5/8" surface casing at 289' with 225 sacks cement.

Dry and Abandoned.

STATE OF KANSAS)
) SS
 COUNTY OF SEDGWICK)

I, GORDON L. KOELLING, do hereby certify that the above and foregoing is a true and correct copy of the log of the BATMAN #2 NE NW NW, Section 2-22-13, Stafford County, Kansas, as reflected by the files of the Musgrove Petroleum Corporation

MUSGROVE PETROLEUM CORPORATION

BY *Gordon L. Koelling*
 Secretary-Treasurer

Subscribed and sworn to before me, a Notary Public, in and for Sedgwick County, Kansas, this 20th day of January, 1954.

William L. Starnes
 Notary Public.

My commission expires September 24, 1956.

RECEIVED
 STATE OF KANSAS

JAN 21 1954

CONSERVATION DIVISION
 Wichita, Kansas

