

STATE OF KANSAS
STATE CORPORATION COMMISSION

WELL PLUGGING RECORD

Give All Information Completely
Make Required Affidavit
Mail or Deliver Report to:
Conservation Division
State Corporation Commission
211 No. Broadway
Wichita, Kansas

Stafford County, Sec. 2 Twp. 22S Rge. 13W (E) (W)

Location as "NE/CNW/SW" or footage from lines. NE NW NE

Lease Owner Anschutz Oil Co., Inc.

Lease Name Runselmeyer Well No. 6

Office Address 380 Denver Hilton Office Building, Denver 2, Colorado

Character of Well (completed as Oil, Gas or Dry Hole) Oil

Date well completed 2-24-54 19

Application for plugging filed 3-25-63 19

Application for plugging approved 3-25-63 19

Plugging commenced 3-20-63 19


Plugging completed 3-25-63 19

Reason for abandonment of well or producing formation Production declined below economic limit.

If a producing well is abandoned, date of last production 9-29-62 19

Was permission obtained from the Conservation Division or its agents before plugging was commenced? Yes

NORTH

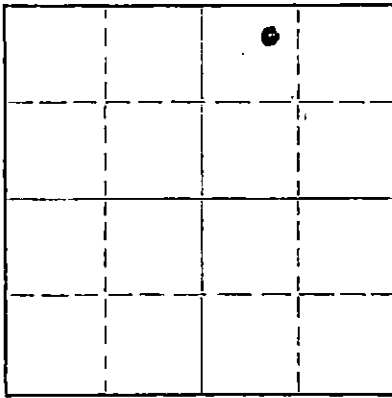

Locate well correctly on above Section Plat

Name of Conservation Agent who supervised plugging of this well Elving

Producing formation Arbuckle Depth to top 3655 Bottom - Total Depth of Well 3696 Feet

Show depth and thickness of all water, oil and gas formations.

OIL, GAS OR WATER RECORDS

CASING RECORD

| FORMATION | CONTENT | FROM | TO | SIZE | PUT IN | PULLED OUT |
|-----------|---------|------|-----------|--------|--------|------------|
| Arbuckle | Oil | 3655 | 3696 (TD) | 5 1/2" | 3656 | 2749 |
| | | | | | | |
| | | | | | | |
Describe in detail the manner in which the well was plugged, indicating where the mud fluid was placed and the method or methods used in introducing it into the hole. If cement or other plugs were used, state the character of same and depth placed, from _____ feet to _____ feet for each plug set.

Sanded back to 3545 ft. dumped 5 sacks cement. Set rock bridge at 200 ft. dumped 20 sacks of cement. Mudded hole up to 40 ft. Dumped 10 sacks cement.

RECEIVED
STATE CORPORATION COMMISSION

APR 15 1963

4-15-63

CONSERVATION DIVISION
WICHITA, KANSAS

(If additional description is necessary, use BACK of this sheet)

Name of Plugging Contractor Central Pipe Pulling Company

Address 1416 Coolidge, Great Bend, Kansas

STATE OF Colorado, COUNTY OF Denver, ss.

John D. Haley (employee of owner) or (owner/operator) of the above-described well, being first duly sworn on oath, says: That I have knowledge of the facts, statements, and matters herein contained and the log of the above-described well as filed and that the same are true and correct. So help me God.

(Signature) John D. Haley

380 Denver Hilton Office Building

(Address)

SUBSCRIBED AND SWORN TO before me this 12th day of April, 1963

Thom E. Pluck

Notary Public.

My commission expires Aug 28, 1965



DRILLER'S LOG

Anschutz Drilling Company
#6 Bunselmeyer
NE NW NE 2-22-13
Stafford County, Kansas

| <u>FROM</u> | <u>TO</u> | |
|-------------|-----------|--------------------|
| 0 | 200 | Sand |
| 200 | 258 | Shale |
| 258 | 545 | Shale & Shells |
| 545 | 740 | Anhydrite |
| 740 | 1230 | Shale & Shells |
| 1230 | 1470 | Salt & Shells |
| 1470 | 1515 | Lime & Shale |
| 1515 | 2000 | Lime |
| 2000 | 2275 | Shale & Lime |
| 2275 | 2425 | Lime & Shale |
| 2425 | 2545 | Shale & Lime |
| 2545 | 2670 | Shale |
| 2670 | 2890 | Shale & Lime |
| 2890 | 3190 | Lime |
| 3190 | 3254 | Lime & Shale |
| 3254 | 3330 | Shale & Lime |
| 3330 | 3590 | Lime |
| 3590 | 3616 | Chert Lime |
| 3616 | 3658 | Lime |
| | 3658 | ROTARY TOTAL DEPTH |

COMMENCED: 1-15-54
COMPLETED: 1-27-54

CASING RECORD

Set 8-5/8" surface casing at 250' with 225 sacks cement.

RECEIVED
STATE CORPORATION COMMISSION

MAY 3 1963

CONSERVATION DIVISION
Wichita, Kansas

STATE OF KANSAS)
COUNTY OF SEDGWICK) 55

I hereby affirm that the above and foregoing is a true and correct copy of the log of the #6 Bunselmeyer located NE NW NE of Section 2-22-13 Stafford County, Kansas.

ANSCHUTZ DRILLING CO., INC.

By _____
E. J. Keating

Subscribed and sworn to before me this 11th day of March, 1954.

Notary Public

My Commission Expires: November 21, 1956