


STATE OF KANSAS
STATE CORPORATION COMMISSION

Give All Information Completely
Make Required Affidavit
Mail or Deliver Report to:
Conservation Division
State Corporation Commission,
800 Blitting Building
Wichita, Kansas


15009-19308-0000
WELL PLUGGING RECORD

OR

FORMATION PLUGGING RECORD

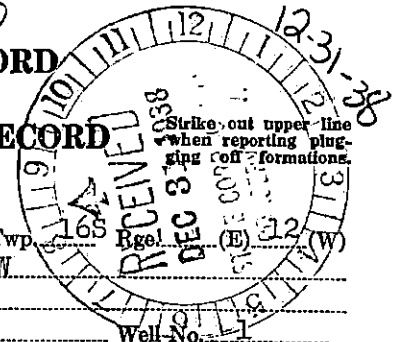

NORTH

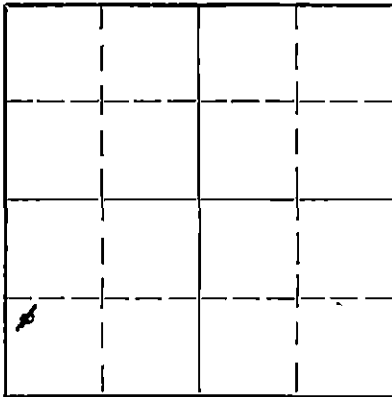

Locate well correctly on above
Section Plat

Location as "NE $\frac{1}{4}$ NW $\frac{1}{4}$ SW $\frac{1}{4}$ " or footage from lines NW SW SW
Lease Owner The Palmer Oil Corporation
Lease Name Miller
Office Address 415 Union National Bank Building, Wichita, Kansas
Character of Well (Completed as Oil, Gas or Dry Hole) Dry Hole
Date, well completed 12/15/38 193
Application for plugging filed 12/14/38 193
Application for plugging approved 12/14/38 193
Plugging Commenced 12/15/38 193
Plugging Completed 12/15/38 193
Reason for abandonment of well or producing formation
If a producing well is abandoned, date of last production 193
Was permission obtained from the Conservation Division or its agents before plugging was commenced? Yes


Name of Conservation Agent who supervised plugging of this well Ed Sheil
Producing formation Depth to top Bottom Total Depth of Well 3356 Feet
Show depth and thickness of all water, oil and gas formations.
OIL, GAS OR WATER RECORDS CASING RECORD

Formation	Content	From	To	Size	Put In	Pulled Out
				10"	202'3"	202'3"
				6 5/8"	3285'8"	2072'4"

Describe in detail the manner in which the well was plugged, indicating where the mud fluid was placed and the method or methods used in introducing it into the hole. If cement or other plugs were used, state the character of same and depth placed, from feet to feet for each plug set.

Total Depth 3356'

Plugged back from 3356 to 3207' with chat, lead wool, cement, and Lane Wells plug and chat from 3207' to 3179'. Cement from 3179' to 3169'. Mud from 3169' to 195'. Bridge 195'. 15' cement on bridge. Mud on cement to 10'. Bridge 10'. Cement on bridge to top of surface pipe at bottom of cellar.

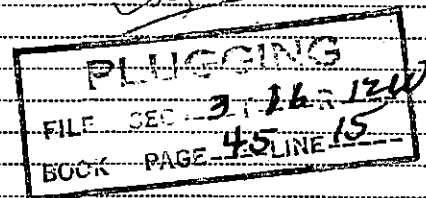

(If additional description is necessary use BACK of this sheet)

Correspondence regarding this well should be addressed to The Palmer Oil Corporation
Address 415 Union National Bank Building, Wichita, Kansas

STATE OF Kansas, COUNTY OF Sedgwick, ss.

Otto H. Schnepel (employee of owner) or (owner or operator) of the above-described well,
being first duly sworn on oath, says: That I have knowledge of the facts, statements, and matters herein contained and the log of the above-described well as filed and that the same are true and correct. So help me God.

(Signature)

Otto H. Schnepel

(Address)

SUBSCRIBED AND SWORN to before me this 29th day of December, 1938

My commission expires March 3, 1941

James Thompson

Notary Public.

TOM PALMER

UNION NATIONAL BANK BUILDING

WICHITA, KANSAS

CASING RECORD

RUN Loss Threads LEFT IN HOLE

20		
15 1/2		
12 1/2		
10	20 1/2	
8 1/4		
6 5/8	10 1/2	10 1/2
5 3/16		

Location NW SW Sec. 3-16-13

Farm Miller #1

County Barton State Kansas

Contractor The Palmer Oil Corporation

Commence 11/15/38

Completed 12/15/38

Elevation 2000'

FORMATION

REMARKS

FEET OF STRATA

TOTAL DEPTH

Shale & Shells		72	72
Sand		33	95
Shale & Shells	(Running surface pipe)	110	205
Shale		66	266
Shale & Shells		100	366
Shale Shells & Red Rock		150	516
Shale & Shells		255	771
Broken Lias		105	876
Shells & Shale		30	906
Salt		210	1116
Broken Lias		180	1296
Shale & Shells		90	1386
Shale & Lias		80	1466
Shale		15	1481
Lias		100	1581
Broken Lias		100	1681
Sand & Lias		60	1741
Sand		10	1751
Broken Lias		115	1866
Lias		65	1931
Broken Lias		405	2336
Shale & Shells		85	2421
Lias		170	2591
Shale		20	2611
Lias, Broken		25	2636
Lias		35	2671
Lias (Top K. S. Lias)		135	2806
Sand		7	2813
Lias		40	2853
Sand		10	2863
Lias		87	2950
Conglomerate		12	2962
Lias		7	2969
Broken Lias	(Running 6 3/8" pipe)	10	2979
Sand		6	2985
Lias, Grey, Hard		2	2987
Lias, Various Colors		27	3014

(Plugged back to 1220'. Hole was dry and abandoned)

P.O.

State of Kansas)
County of Sedgewick) ss

Mr. Otto E. Schaeppel, being first duly sworn on oath, states that he is the Secretary of The Palmer Oil Corporation, that as such officer, he is personally familiar with the records of The Palmer Oil Corporation, and that the above well log is a true, correct and accurate copy of the original well log of Well #1, Miller Farm, NW 23 33, Section 3-16-13, Barton County, Kansas.

Signed

Attest:

Subscribed and sworn before me this _____ day of December, 1938.

My commission expires _____

Notary Public.