


15-09-01607-0000
WELL PLUGGING RECORD

All Information Completely
Required Affidavit
or Deliver Report to:
Conservation Division
State Corporation Commission
211 No. Broadway
Wichita, Kansas

NORTH

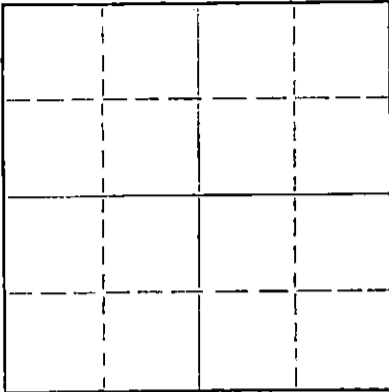

Locate well correctly on above
Section Plat

Barton County. Sec. 3 Twp. 16S Rge. 12W (NE) (W)
Location as "NE/CNW/SW" or footage from lines NE NW NW
Lease Owner Herman George Kaiser, Oil Producer
Lease Name Weber Well No. 1
Office Address 909 Palace Building, Tulsa, Oklahoma
Character of Well (completed as Oil, Gas or Dry Hole) Dry Hole
Date well completed 9-8-63 19
Application for plugging filed 9-8-63 19
Application for plugging approved 9-8-63 19
Plugging commenced 9-8-63 19
Plugging completed 9-8-63 19
Reason for abandonment of well or producing formation Dry Hole

If a producing well is abandoned, date of last production _____ 19____
Was permission obtained from the Conservation Division or its agents before plugging was com-
menced? yes

Name of Conservation Agent who supervised plugging of this well Donald Truan, Russell, Kansas
Producing formation _____ Depth to top _____ Bottom _____ Total Depth of Well 3355 Feet
Show depth and thickness of all water, oil and gas formations.

OIL, GAS OR WATER RECORDS

CASING RECORD

FORMATION	CONTENT	FROM	TO	SIZE	PUT IN	PULLED OUT
				8 5/8"	311'	none

Describe in detail the manner in which the well was plugged, indicating where the mud fluid was placed and the method or methods used in introducing it into the hole. If cement or other plugs were used, state the character of same and depth placed, from _____ feet to _____ feet for each plug set.

Mud to 300' Plug & 1/4 sk. hulls & 25 sacks Cement through drill pipe
Mud to 40' Plug & 1/2 sk. hulls and 10 sacks cement to base of cellar

RECEIVED
STATE CORPORATION COMMISSION
SEP 11 1963
09-11-63
CONSERVATION DIVISION
Wichita, Kansas

(If additional description is necessary, use BACK of this sheet)

Name of Plugging Contractor Leben Drilling, Inc.
Address P. O. Box 486, Great Bend, Kansas

STATE OF KANSAS, COUNTY OF BARTON, ss.

Leslie Kite (employee of owner) or (owner or operator) of the above-described well, being first duly sworn on oath, says: That I have knowledge of the facts, statements, and matters herein contained and the log of the above-described well as filed and that the same are true and correct. So help me God.

(Signature) Leslie Kite
P. O. Box 486, Great Bend, Kansas
(Address)

SUBSCRIBED AND SWORN TO before me this 10th day of September, 19 63

My commission expires April 1, 1967

Ulanda Nichols
Ulanda Nichols
Notary Public.

DRILLER'S LOG

COMPANY: Herman George Kaiser,
Oil Producer
CONTRACTOR: LEBEN DRILLING, INC.
FARM: WEBER #1
LOCATION: NE NW NW Sec. 3-16S-12W
BARTON COUNTY, KANSAS
COMMENCED: 8-31-63
COMPLETED: 9-8-63

0	162	Top Soil, Post Rock, Sand
162	311	Shale & Shells
311	435	Shale, Sand
435	445	Pyrite with Shale
445	670	Shale & Redbed
670	765	Redbed
765	795	Anhydrite
795	1490	Shale
1490	1820	Shale & Lime
1820	1975	Lime
1975	2175	Shale & Lime
2175	2380	Lime & Shale
2380	2625	Shale, Lime
2625	2825	Lime & Shale
2825	2953	Lime
2953	3075	Lime & Shale
3075	3355	Lime
	<u>3355</u>	<u>Rotary Total Depth - D. & A.</u>

RECEIVED
STATE CORPORATION COMMISSION

SEP 11 1963

CONSERVATION DIVISION
Wichita, Kansas

Set 8 5/8" used surface casing @ 311' with landing joint with 175 sacks of Posmix with Sunset.

I, Leslie Kite, do hereby certify that the above and foregoing is a true and correct copy of the log of the Weber #1, located NE NW NW of Section 3, Township 16 South, Range 12 West, Barton County, Kansas, as reflected by the files of Leben Drilling, Inc.

Leslie Kite

Leslie Kite

STATE OF KANSAS)
) SS
COUNTY OF BARTON)

Subscribed and sworn to before me, a Notary Public, in and for Barton County, Kansas, this 10th day of September, 1963.

Ulanda Nichols

Ulanda Nichols, Notary Public

My Commission Expires:
April 1, 1967