


15-185-00683-0000

WELL PLUGGING RECORD

Give All Information Completely  
Make Required Affidavit  
Mail or Deliver Report to:  
Conservation Division  
State Corporation Commission  
806 Bittling Building  
Wichita, Kansas

Stafford County, Sec. 36 Twp. 23 Rge. 13 (W)

Location as "NE/CNW/SW" or footage from lines NE NE NE  
Lease Owner Loffland Brothers Company  
Lease Name Michaelis Well No. 1  
Office Address Box 1649, Tulsa, Oklahoma  
Character of Well (completed as Oil, Gas or Dry Hole) Dry hole  
Date well completed March 11 19 55  
Application for plugging filed March 11 19 55  
Application for plugging approved March 11 19 55  
Plugging commenced March 11 19 55  
Plugging completed March 11 19 55  
Reason for abandonment of well or producing formation \_\_\_\_\_

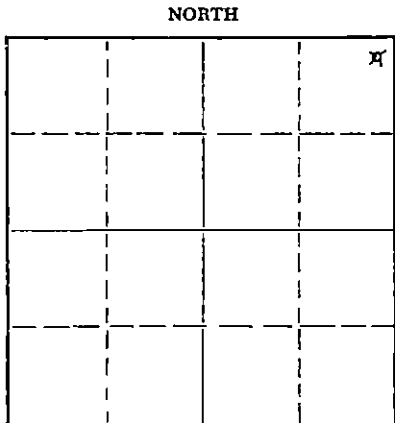

Locate well correctly on above Section Plat

If a producing well is abandoned, date of last production \_\_\_\_\_ 19 \_\_\_\_\_  
Was permission obtained from the Conservation Division or its agents before plugging was commenced? Yes

Name of Conservation Agent who supervised plugging of this well Warren H. Horner  
Producing formation \_\_\_\_\_ Depth to top \_\_\_\_\_ Bottom \_\_\_\_\_ Total Depth of Well 4,000 Feet  
Show depth and thickness of all water, oil and gas formations.

OIL, GAS OR WATER RECORDS

CASING RECORD

FORMATION	CONTENT	FROM	TO	SIZE	PUT IN	PULLED OUT

Describe in detail the manner in which the well was plugged, indicating where the mud fluid was placed and the method or methods used in introducing it into the hole. If cement or other plugs were used, state the character of same and depth placed, from surface feet to 205 feet for each plug set.

Using Halliburton Cementing Company mixed and pumped 70 sax cement in 8 5/8" casing preceded with Halliburton plug.

3-23-55

Name of Plugging Contractor Own tools - Halliburton (If additional description is necessary, use BACK of this sheet)  
Address \_\_\_\_\_

STATE OF OKLAHOMA, COUNTY OF TULSA, ss.  
R. J. MEERS (employee of owner) or (owner or operator) of the above-described well, being first duly sworn on oath, says: That I have knowledge of the facts, statements, and matters herein contained and the log of the above-described well as filed and that the same are true and correct. So help me God.

(Signature) [Signature]  
P. O. Box 1649, Tulsa, Oklahoma (Address)

SUBSCRIBED AND SWORN TO before me this 18th day of March, 1955

My commission expires January 22, 1958

Patricia E. Ludewick Notary Public.

PLUGGING  
FILE SEC 36, 23 & 13W  
BOOK PAGE 103 LINE 42

DRILLER'S LOG

Michaelis No. 1  
NE NE NE Sec. 36-23-13W  
Stafford County, Kansas

15-185-00683-0000

<u>DEPTH</u>		<u>FORMATION</u>
<u>From</u>	<u>To</u>	
0	41	Sand and clay
41	230	Sand and shale
230	690	Sand and red bed
690	785	Anhydrite
785	1240	Shale and shells
1240	1640	Salt and shale
1640	1887	Lime and shale
1887	2060	Lime
2060	3338	Shale and lime
3338	3463	Shale
3463	3500	Lime
3500	3580	Shale and lime
3580	3690	Lime
3690	3746	Lime and shale
3746	3817	Lime
3817	3893	Cherty Lime
3893	3955	Shale and sand.
3955	4000	Shale and lime
	4000 T.D.	

**PLUGGING**  
FILE SEC 36 T 23 R 13W  
BOOK PAGE 103 LINE 42

STATE GEOLOGICAL SURVEY  
MAR 23 1955  
CONSERVATION DIVISION  
Wichita, Kansas