

CARD MUST BE TYPED

State of Kansas

CARD MUST BE SIGNED

# NOTICE OF INTENTION TO DRILL

(see rules on reverse side)

Expected Spud Date..... 10 28 87  
month day year

API Number 15— 185-22,477-0000

D+A

OPERATOR: License # 09408  
Name Trans Pacific Oil Corporation  
Address 410 One Main Place  
City/State/Zip Wichita, Ks. 67202  
Contact Person Alan D. Banta  
Phone 316-262-3596

SE NE NW Sec. 4 Twp. 22 S, Rg. 13  
4290 Ft. from South Line of Section  
2970 Ft. from East Line of Section

(Note: Locate well on Section Plat on reverse side)

CONTRACTOR: License # 05841  
Name Trans Pac Drilling  
City/State Wichita, Ks. 67202

Nearest lease or unit boundary line ..... feet  
County Stafford  
Lease Name Chase Well Service Well # 1

Well Drilled For: Well Class: Type Equipment:  
 Oil  Storage  Infield  Mud Rotary  
 Gas  Inj  Pool Ext.  Air Rotary  
 OWWO  Expl  Wildcat  Cable

Ground surface elevation est 1880 feet MSL  
Domestic well within 330 feet:  yes  no  
Municipal well within one mile:  yes  no

If OWWO: old well info as follows:  
Operator  
Well Name  
Comp Date Old Total Depth

Depth to bottom of fresh water .....  
Depth to bottom of usable water 230  
Surface pipe by Alternate: 1<sup>X</sup> 2  
Surface pipe planned to be set 250  
Conductor pipe required .....  
Projected Total Depth 3750 feet  
Formation Arbuckle

I certify that well will comply with K.S.A. 55-101, et seq., plus eventually plugging hole to KCC specifications.

Date 10/26/87 Signature of Operator or Agent Sandra Jellis Title Office Manager


For KCC Use:  
Conductor Pipe Required ..... feet; Minimum Surface Pipe Required 250 feet per Alt. 1  
This Authorization Expires 4-26-88 Effective 10-31-87 Approved By Pett 10-26-87

Must be filed with the K.C.C. five (5) days prior to commencing well  
This card void if drilling not started within six (6) months of date received by K.C.C.

**Important procedures to follow:**

1. Notify District office before setting surface casing.
2. Set surface casing by circulating cement to the top.
3. File completion forms ACO-1 with K.C.C. within 120 days of well spud date, following instructions on ACO-1, side 1, and including copies of wireline logs.
4. *10-26-87* Notify District office 48 hours prior to old well workover or re-entry.
5. Prior to filing Intent, prepare a proposed plugging plan in case well is D & A, then obtain approval of plan when calling district office prior to setting surface pipe.
6. Submit plugging report (CP-4) to K.C.C. after plugging is completed.
7. Obtain an approved injection docket number before disposing of salt water.
8. Notify K.C.C. within 10 days when injection commences or terminates.
9. If an alternate 2 completion, cement in the production pipe from below any usable water to surface within 120 days of spud date.

**A Regular Section of Land**  
**1 Mile = 5,280 Ft.**

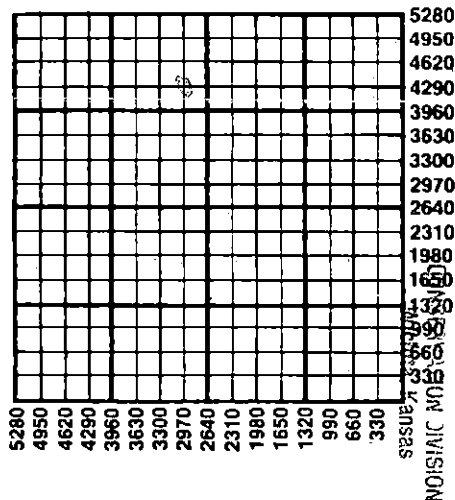

OCT 26 1987

RECEIVED  
STATE CORPORATION COMMISSION

State Corporation Commission of Kansas  
Conservation Division  
200 Colorado Derby Building  
Wichita, Kansas 67202-1212  
(316) 263-3238