

NOTICE OF INTENTION TO DRILL

(see rules on reverse side)

Starting Date 1 11 86
 month day year

API Number 15— 009-24,151-00-00

OPERATOR: License # 5122 100'
 Name Woodman-Iannitti Drilling Co.
 Address 704 Union Center Bldg.
 City/State/Zip Wichita, Kansas 67202
 Contact Person Peter L. Iannitti
 Phone (316) 265-7650

SW SE NE SW Sec. 2 Twp. 16 S, Rg. 12 — East
 1600 X West
 3020 Ft. from South Line of Section
 Ft. from East Line of Section

(Note: Locate well on Section Plat on reverse side)

CONTRACTOR: License # 5122
 Name Woodman-Iannitti Drilling Co.
 City/State Wichita, Kansas

Nearest lease or unit boundary line 1040 feet

County Barton
 Lease Name Schauf Well # 1

Ground surface elevation not yet available feet MSL

Well Drilled For: Well Class: Type Equipment:
 Oil SWD Infield Mud Rotary
 Gas Inj Pool Ext. Air Rotary
 OWWO Expl Wildcat Cable

Domestic well within 330 feet: —yes no
 Municipal well within one mile: —yes no
 Surface pipe by Alternate: 1 2

If OWWO: old well info as follows:

Depth to bottom of fresh water 200
 Depth to bottom of usable water 330
 Surface pipe planned to be set 350
 Projected Total Depth 3350 feet
 Formation Arbuckle

Operator
 Well Name
 Comp Date Old Total Depth.....

I certify that well will comply with K.S.A. 55-101, et seq., plus eventually plugging hole to KCC specifications.

_____ cementing will be done immediately upon setting production casing.

Date 1-7-86 Signature of Operator or Agent *P.L. Iannitti* Title Partner

For KCC Use:

Conductor Pipe Required feet; Minimum Surface Pipe Required 350 feet per Alt.

This Authorization Expires 2-7-86 Approved By *[Signature]* 1-7-86

Must be filed with the K.C.C. five (5) days prior to commencing well
This card void if drilling not started within six (6) months of date received by K.C.C.


Important procedures to follow:

1. Notify District office before setting surface casing.
2. Set surface casing by circulating cement to the top.
3. File completion forms ACO-1 with K.C.C. within 90 days of well completion, following instructions on ACO-1, side 1, and including copies of wireline logs.
4. Notify District office 48 hours prior to old well workover or re-entry.
5. Prior to filing Intent, prepare a proposed plugging plan in case well is D & A, then obtain approval of plan when calling district office prior to setting surface pipe.
6. Submit plugging report (CP-4) to K.C.C. after plugging is completed.
7. Obtain an approved injection docket number before disposing of salt water.
8. Notify K.C.C. within 10 days when injection commences or terminates.
9. If an alternate 2 completion, cement in the production pipe from below any usable water to surface within 120 days of spud date.

RECEIVED
STATE CORPORATION COMMISSION

A Regular Section of Land AN
1 Mile = 5,280 Ft.

1 - 7 - 86
CONSERVATION DIVISION
Wichita, Kansas

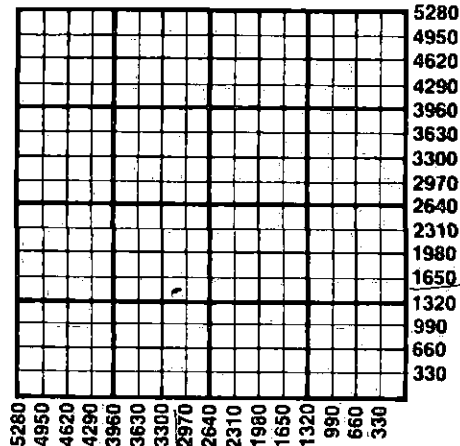

State Corporation Commission of Kansas
Conservation Division
200 Colorado Derby Building
Wichita, Kansas 67202
(316) 263-3238