

CARD MUST BE TYPED

State of Kansas
NOTICE OF INTENTION TO DRILL

CARD MUST BE SIGNED

(see rules on reverse side)

Starting Date: July 29, 1985
month day year

API Number 15- 185-22,263-0000

OPERATOR: License # 7916
Name Eldon J. Schierling - Dynoxl, Inc.
Address 850 Sutton Place
City/State/Zip Wichita, Kansas 67202
Contact Person EJS
Phone (316) 267-0042

SW SE NW ... Sec 29. Twp 23. S, Rge 13 East West
(location)

2970 Ft North from Southeast Corner of Section
3630 Ft West from Southeast Corner of Section
(Note: Locate well on Section Plat on reverse side)

CONTRACTOR: License # 5418
Name Allen Drilling Company
City/State Box 1389, Great Bend, KS 67530

Nearest lease or unit boundary line 330 feet.
County Stafford
Lease Name Cornwell Well# 1

Well Drilled For: Well Class: Type Equipment:
 Oil Swd Infield Mud Rotary
 Gas Inj Pool Ext. Air Rotary
 OWWO Expl Wildcat Cable

Domestic well within 330 feet: yes no
Municipal well within one mile: yes no

If OWWO: old well info as follows:

Operator
Well Name
Comp Date Old Total Depth
Projected Total Depth 3600 feet
Projected Formation at TD Arbuckle
Expected Producing Formations Lansing-Arbuckle

Depth to Bottom of fresh water 102 feet
Lowest usable water formation Top of Permian
Depth to Bottom of usable water 250 feet
Surface pipe by Alternate: 1 2
Surface pipe to be set 330 feet
Conductor pipe if any required none feet
Ground surface elevation NA feet MSL
This Authorization Expires 1-26-86
Approved By RCH 7-26-85

I certify that we will comply with K.S.A. 55-101, et seq., plus eventually plugging hole to K.C.C. specifications.

Date 7/26/85 Signature of Operator or Agent *Eldon J. Schierling* Title Operator

Must be filed with the K.C.C. five (5) days prior to commencing well
This card void if drilling not started within six (6) months of date received by K.C.C.

RECEIVED
STATE CORPORATION COMMISSION


7-26-85 Important procedures to follow:

A Regular Section of Land
1 Mile = 5,280 Ft.

1111 2.6 1985

Wichita, Kansas

1. Notify District office before setting surface casing.
2. Set surface casing by circulating cement to the top.
3. File completion forms ACO-1 with K.C.C. within 90 days of well completion, following instructions on ACO-1, side 1, and including copies of wireline logs.
4. Notify District office 48 hours prior to old well workover or re-entry.
5. Prior to plugging, prepare a plugging plan, then obtain agreement from the appropriate district office for an approved plugging plan.
6. Submit plugging report (CP-4) to K.C.C. after plugging is completed.
7. Obtain an approved injection docket number before disposing of salt water.
8. Notify K.C.C. within 10 days when injection commences or terminates.
9. If an alternate 2 completion, cement in the production pipe from below any usable water to surface within 120 days of spud date.

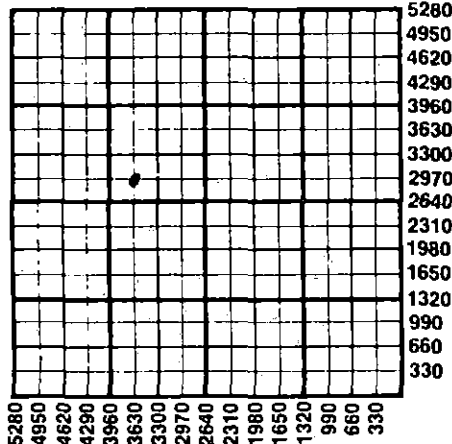

State Corporation Commission of Kansas
Conservation Division
200 Colorado Derby Building
Wichita, Kansas 67202
(316) 263-3238