

CARD MUST BE TYPED

State of Kansas

CARD MUST BE SIGNED

NOTICE OF INTENTION TO DRILL

CORRECTION
1-886

(see rules on reverse side)

CORRECTED INTENT

Starting Date January 10 1986
month day year

API Number 15— 185-22,296-6000

OPERATOR: License # 9324

NE. NE. NE. Sec. 30. Twp. 23 S, Rg. 13 East
_____ West

Name JFW, Inc.

4950 Ft. from South Line of Section

Address RR #1 Box 26

330 Ft. from East Line of Section

City/State/Zip Plevna, Kan. 67568

(Note: Locate well on Section Plat on reverse side)

Contact Person Elsie L. McNemee

Phone 316-286-5253

Nearest lease or unit boundary line 330 feet

CONTRACTOR: License # 4087

County Stafford

Name Williamson Drilling, Inc.

Lease Name Cornwell Well # 1-30

City/State Great Bend, Kan. 67530

Ground surface elevation 1888 feet MSL

Well Drilled For: Well Class: Type Equipment:

Domestic well within 330 feet: _____ yes X no

X Oil _____ SWD _____ Infield X Mud Rotary

Municipal well within one mile: _____ yes _____ no

_____ Gas _____ Inj _____ Pool Ext. _____ Air Rotary

Surface pipe by Alternate: 1 X 2 _____

_____ OWWO _____ Expl X Wildcat _____ Cable

Depth to bottom of fresh water.....

If OWWO: old well info as follows:

Depth to bottom of usable water 250

Operator

Surface pipe planned to be set ... set @ 275

Well Name

Projected Total Depth ... 40.50± feet

Comp Date Old Total Depth.....

Formation Arbuckle

I certify that well will comply with K.S.A. 55-101, et seq., plus eventually plugging hole to KCC specifications. *for* Elton J. Schickling

X _____ cementing will be done immediately upon setting production casing.

Date .. 1-7-86 Signature of Operator or Agent *Elsie L. McNemee* Title Operator # 2

For KCC Use:

Conductor Pipe Required feet; Minimum Surface Pipe Required feet per Alt. 1 2


This Authorization Expires 4-7-86 Approved By 10-7-85

Must be filed with the K.C.C. five (5) days prior to commencing well
This card void if drilling not started within six (6) months of date received by K.C.C.

Important procedures to follow:

1. Notify District office before setting surface casing.
2. Set surface casing by circulating cement to the top.
3. File completion forms ACO-1 with K.C.C. within 90 days of well completion, following instructions on ACO-1, side 1, and including copies of wireline logs.
4. Notify District office 48 hours prior to old well workover or re-entry.
5. Prior to filing Intent, prepare a proposed plugging plan in case well is D & A, then obtain approval of plan when calling district office prior to setting surface pipe.
6. Submit plugging report (CP-4) to K.C.C. after plugging is completed.
7. Obtain an approved injection docket number before disposing of salt water.
8. Notify K.C.C. within 10 days when injection commences or terminates.
9. If an alternate 2 completion, cement in the production pipe from below any usable water to surface within 120 days of spud date.

A Regular Section of Land 1 Mile = 5,280 Ft.

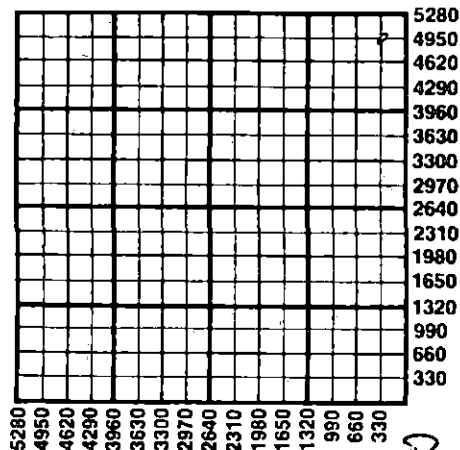

Reed
10-7-85

State Corporation Commission of Kansas
Conservation Division
200 Colorado Derby Building
Wichita, Kansas 67202
(316) 263-3238