

CARD MUST BE TYPED

State of Kansas

CARD MUST BE SIGNED

NOTICE OF INTENTION TO DRILL

(see rules on reverse side)

Expected Spud Date. March 16 1988
month day yearAPI Number 15— 185-22,505-0000 ✓ 12
NE SW NE Sec. 11 Twp. 23 S, Rg. 13 XX East
3630 Ft. from South Line of Section
1650 Ft. from East Line of SectionOPERATOR: License # 9247
Name Cincris Energy Company, Inc.
Address 4600 Camelot East
City/State/Zip Great Bend, KS 67530
Contact Person Bill Riley
Phone 316 792-6228(Note: Locate well on Section Plat on reverse side)
Nearest lease or unit boundary line 330 feet
County Stafford
Lease Name Wesley Well # 2
Ground surface elevation est. 1865 feet MSLCONTRACTOR: License # 5122
Name Woodman-Iannitti
City/State Great Bend, KSDomestic well within 330 feet: no X yes
Municipal well within one mile: no X yes
Depth to bottom of fresh water 200
Depth to bottom of usable water 200
Surface pipe by Alternate: 220 1 X 2
Surface pipe planned to be set
Conductor pipe required N/A
Projected Total Depth 3860 feet
Formation ArbuckleWell Drilled For: Well Class: Type Equipment:
X Oil — Storage — Infield X Mud Rotary
— Gas — Inj. X Pool Ext. — Air Rotary
— OWWO — Expl — Wildcat — Cable

If OWWO: old well info as follows:

Operator
Well Name
Comp Date Old Total Depth

I certify that well will comply with K.S.A. 55-101, et seq., plus eventually plugging hole to KCC specifications.

Date 2-24-88 Signature of Operator or Agent William V. Riley Title Pres.

For KCC Use:


Conductor Pipe Required 220 feet; Minimum Surface Pipe Required 220 feet per Alt. DX
This Authorization Expires 9-16-88 Approved By Pet. 3-16-88EFFECTIVE DATE: 3-21-88

Must be filed with the K.C.C. five (5) days prior to commencing well
This card void if drilling not started within six (6) months of date received by K.C.C.

Important procedures to follow:

1. Notify District office before setting surface casing.
2. Set surface casing by circulating cement to the top.
3. File completion forms ACO-1 with K.C.C. within 120 days of well spud date, following instructions on ACO-1, side 1, and including copies of wireline logs.
4. Notify District office 48 hours prior to old well workover or re-entry.
5. Prior to filing Intent, prepare a proposed plugging plan in case well is D & A, then obtain approval of plan when calling district office prior to setting surface pipe.
6. Submit plugging report (CP-4) to K. C. C. after plugging is completed.
7. Obtain an approved injection docket number before disposing of salt water.
8. Notify K.C.C. within 10 days when injection commences or terminate.
9. If an alternate 2 completion, cement in the production pipe from below any usable water to surface within 120 days of spud date.

**A Regular Section of Land
1 Mile = 5,280 Ft.**

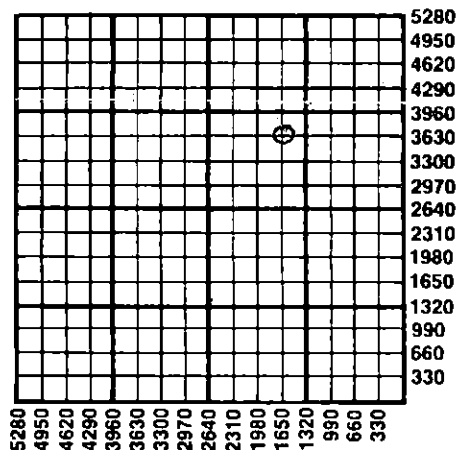

RECEIVED
STATE CORPORATION COMMISSION

MAR 16 1988
3-16-88
CONSERVATION DIVISION
Wichita, Kansas

State Corporation Commission of Kansas
Conservation Division
200 Colorado Derby Building
Wichita, Kansas 67202-1212
(316) 263-3238