

CARD MUST BE TYPED

State of Kansas
NOTICE OF INTENTION TO DRILL
(see rules on reverse side)

1912-340

CARD MUST BE SIGNED

Starting Date: 3- 30 85
month day year

API Number 15- 009-01,025-00-01

OPERATOR: License # 9421
Name Boger Brothers Drilling, Inc.
Address 254 West Second - P. O. Box 120
City/State/Zip Hoisington, Kansas 67544
Contact Person mark Boger
Phone 316-653-7341 or 316-653-2100

SE- SW- SE Sec 33 Twp 16 S, Rge 11 East
(location) West

330 Ft North from Southeast Corner of Section
1650 Ft West from Southeast Corner of Section
(Note: Locate well on Section Plat on reverse side)

CONTRACTOR: License # 9421
Name Boger Brothers Drilling, Inc.
City/State Hoisington, Kansas 67544

Nearest lease or unit boundary line 330 feet.
County Barton
Lease Name Wilborn Well# #2

Well Drilled For: Well Class: Type Equipment:
 Oil Swd Infield Mud Rotary
 Gas Inj Pool Ext. Air Rotary
 OWWO Expl Wildcat Cable

Domestic well within 330 feet: yes no
Municipal well within one mile: yes no

If OWWO: old well info as follows:
Operator Sinclair Prairie Oil co.
Well Name Harzman #3
Comp Date 4-1-46 Old Total Depth 3360
Projected Total Depth 3600 feet
Projected Formation at TD Granite Wash
Expected Producing Formations SWDW

Depth to Bottom of fresh water 170 mhc feet
Lowest usable water formation Dakota
Depth to Bottom of usable water 370 mhc feet
Surface pipe by Alternate: 1 2
Surface pipe ~~to~~ set Existing 310 feet
Conductor pipe if any required feet
Ground surface elevation 1889 feet MSL
This Authorization Expires 9-27-85
Approved By 3-27-85

I certify that we will comply with K.S.A. 55-101, et seq., plus eventually plugging hole to K.C.C. specifications.

Date 3-25-85 Signature of Operator or Agent

Mark L Boger Title President

MHC/KOHE 3-27-85


Must be filed with the K.C.C. five (5) days prior to commencing well
This card void if drilling not started within six (6) months of date received by K.C.C.

RECEIVED
STATE CORPORATION COMMISSION

3-27-85
MAR 27 1985

Important procedures to follow:
CONSERVATION DIVISION
Wichita, Kansas

A Regular Section of Land
1 Mile = 5,280 Ft.

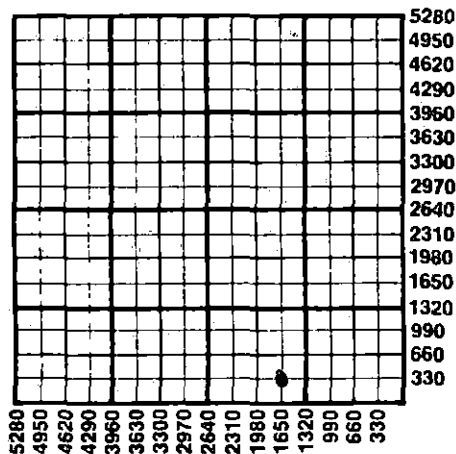

1. Notify District office before setting surface casing.
2. Set surface casing by circulating cement to the top.
3. File completion forms ACO-1 with K.C.C. within 90 days of well completion, following instructions on ACO-1, side 1, and including copies of wireline logs.
4. Notify District office 48 hours prior to old well workover or re-entry.
5. Prior to plugging, prepare a plugging plan, then obtain agreement from the appropriate district office for an approved plugging plan.
6. Submit plugging report (CP-4) to K.C.C. after plugging is completed.
7. Obtain an approved injection docket number before disposing of salt water.
8. Notify K.C.C. within 10 days when injection commences or terminates.
9. If an alternate 2 completion, cement in the production pipe from below any usable water to surface within 120 days of spud date.

State Corporation Commission of Kansas
Conservation Division
200 Colorado Derby Building
Wichita, Kansas 67202
(316) 263-3238