

CARD MUST BE TYPED

State of Kansas  
**NOTICE OF INTENTION TO DRILL**

CARD MUST BE SIGNED

(see rules on reverse side)

Starting Date: ..... 2- 1- 85  
month day year

API Number 15- 009-23,869,000

OPERATOR: License # 9421  
Name Boger Brothers Drilling, Inc.  
Address 254 West Second - P. O. Box 120  
City/State/Zip Hoisington, Ks 67544  
Contact Person Mark Boger  
Phone 316-653-7341

NE .. SW .. SE Sec 33 .. Twp 16 .. S, Rge 11 ..  East  
(location)  West

990 ..... Ft North from Southeast Corner of Section  
1650 ..... Ft West from Southeast Corner of Section  
(Note: Locate well on Section Plat on reverse side)

CONTRACTOR: License # 9421  
Name Boger Brothers Drilling, Inc.  
City/State Hoisington, Kansas 67544

Nearest lease or unit boundary line ..... 330 ..... feet.  
County Barton  
Lease Name Wilborn Well# 1

Well Drilled For: Well Class: Type Equipment:  
 Oil  Swd  Infield  Mud Rotary  
 Gas  Inj  Pool Ext.  Air Rotary  
 OWWO  Expl  Wildcat  Cable

Domestic well within 330 feet:  yes  no  
Municipal well within one mile:  yes  no

If OWWO: old well info as follows:  
Operator .....  
Well Name .....  
Comp Date ..... Old Total Depth .....  
Projected Total Depth 3300 ..... feet  
Projected Formation at TD Arbuckle  
Expected Producing Formations Arbuckle-Conglomerate

Depth to Bottom of fresh water <sup>370</sup> 190 <sup>MHC</sup> ..... feet  
Lowest usable water formation Dakota  
Depth to Bottom of usable water 370 <sup>MHC</sup> ..... feet  
Surface pipe by Alternate: 1  2   
Surface pipe to be set 370 ..... feet  
Conductor pipe if any required ..... feet  
Ground surface elevation ..... feet MSL  
This Authorization Expires 7-23-85  
Approved By 1-23-85 *RB*

I certify that we will comply with K.S.A. 55-101, et seq., plus eventually plugging holes to K.C.C. specifications.


Date 1-22-85 Signature of Operator or Agent *Mark J Boger* Title President

*MHC/KOHE 1-23-85*

Must be filed with the K.C.C. five (5) days prior to commencing well  
This card void if drilling not started within six (6) months of date received by K.C.C.

**Important procedures to follow:**

**A Regular Section of Land  
1 Mile = 5,280 Ft.**

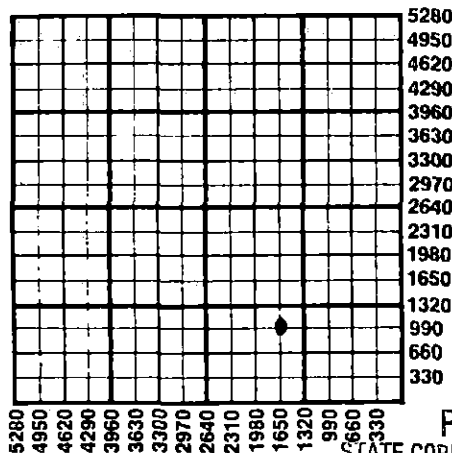

1. Notify District office before setting surface casing.
2. Set surface casing by circulating cement to the top.
3. File completion forms ACO-1 with K.C.C. within 90 days of well completion, following instructions on ACO-1, side 1, and including copies of wireline logs.
4. Notify District office 48 hours prior to old well workover or re-entry.
5. Prior to plugging, prepare a plugging plan, then obtain agreement from the appropriate district office for an approved plugging plan.
6. Submit plugging report (CP-4) to K.C.C. after plugging is completed.
7. Obtain an approved injection docket number before disposing of salt water.
8. Notify K.C.C. within 10 days when injection commences or terminates.
9. If an alternate 2 completion, cement in the production pipe from below any usable water to surface within 120 days of epud date.

RECEIVED

STATE CORPORATION COMMISSION

JAN 23 1985  
01-23-85  
CONSERVATION DIVISION  
Wichita, Kansas

State Corporation Commission of Kansas  
Conservation Division  
200 Colorado Derby Building  
Wichita, Kansas 67202  
(316) 263-3238