


STATE OF KANSAS  
 STATE CORPORATION COMMISSION  
 CONSERVATION DIVISION  
 P. O. BOX 17027  
 WICHITA, KANSAS 67217

FORM CP-4

WELL PLUGGING RECORD

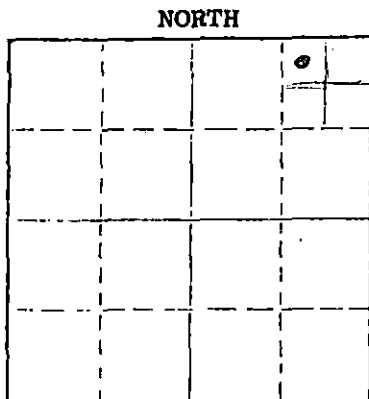

Locate well correctly on above Section Plat

Stafford County, Sec. 4 Twp. 22 Rge. (E) 13 (W)  
 Location as "NE/CNW/SE/SW" or footage from lines C NW NE NE  
 Lease Owner RW Production Company  
 Lease Name Gates Well No. 1  
 Office Address 1315 N. Broadway Ada, Oklahoma 74820  
 Character of Well (completed as Oil, Gas or Dry Hole) Dry Hole  
 Date well completed 3/23/75 19  
 Application for plugging filed 5/29/75 19  
 Application for plugging approved 3/26/75 19  
 Plugging commenced 3/23/75 19  
 Plugging completed 3/23/75 19  
 Reason for abandonment of well or producing formation Dry Hole

If a producing well is abandoned, date of last production 19  
 Was permission obtained from the Conservation Division or its agents before plugging was commenced? Yes

Name of Conservation Agent who supervised plugging of this well G. Russell Biberstein  
 Producing formation None Depth to top Bottom Total Depth of Well 3770 Feet  
 Show depth and thickness of all water, oil and gas formations.

OIL, GAS OR WATER RECORDS

CASING RECORD

FORMATION	CONTENT	FROM	TO	SIZE	PUT IN	PULLED OUT
				8-5/8	286	None

Describe in detail the manner in which the well was plugged, indicating where the mud fluid was placed and the method or methods used in introducing it into the hole. If cement or other plugs were used, state the character of same and depth placed, from feet to feet for each plug set.

35 sack cement plug placed in bottom of surface pipe  
 15 sack cement plug placed in top of surface pipe  
 2 sack cement plug placed in rat hole  
 Hole was full of drilling mud.

Name of Plugging Contractor H-30, Inc. (If additional description is necessary, use BACK of this sheet)  
 Address 200 N. Main Wichita, Kansas 67202

STATE OF Oklahoma COUNTY OF Pontotoc, ss.

(employee of owner) or (owner or operator) of the above-described well, being first duly sworn on oath, says: That I have knowledge of the facts, statements, and matters herein contained and the log of the above-described well as filed and that the same are true and correct. So help me God.

(Signature) *[Signature]*  
 P.O. Box 1594 Ada, Okla 74820 (Address)

Subscribed and sworn to before me this 29 day of May 19 75

My commission expires May 30, 1978 Notary Public. *[Signature]*

RECEIVED  
 STATE CORPORATION COMMISSION  
 JUN 5 1975  
 CONSERVATION DIVISION  
 Wichita, Kansas

6-5-75

**KANSAS DRILLERS LOG**


S. 4 T. 22 R. 13 <sup>E</sup>/<sub>W</sub>

API No. 15 — 185 — 20,575 -0000  
 County Number

Loc. NW NE NE

County Stafford

640 Acres  
N

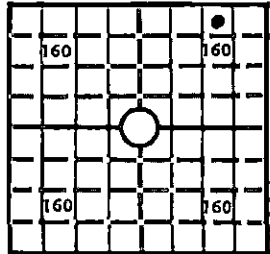

Locate well correctly  
Elev.: Gr. 1889

DF 1891 KB 1894

Operator  
R. W. Production Co.

Address  
Box 594 Ada, Oklahoma

Well No. #1 Lease Name Gates

Footage Location  
330 feet from (N) (S) line 990 feet from (E) (W) line

Principal Contractor H-30, Inc. Geologist Gerald Becker

Spud Date 3/15/75 Total Depth 3770 P.B.T.D.

Date Completed 3/23/75 Oil Purchaser None

**CASING RECORD**

Report of all strings set—surface, intermediate, production, etc.

Purpose of string	Size hole drilled	Size casing set (in O.D.)	Weight lbs/ft.	Setting depth	Type cement	Sacks	Type and percent additives
Surface		8-5/8	28	286	Bulk	250	470 lbs Gel

**LINER RECORD**

**PERFORATION RECORD**

Top, ft.	Bottom, ft.	Sacks cement	Shots per ft.	Size & type	Depth interval

Size	Setting depth	Pecker set at

**ACID, FRACTURE, SHOT, CEMENT SQUEEZE RECORD**

Amount and kind of material used	Depth interval treated

**INITIAL PRODUCTION**

Date of first production \_\_\_\_\_ Producing method (flowing, pumping, gas lift, etc.) \_\_\_\_\_

RATE OF PRODUCTION PER 24 HOURS	Oil	Gas	Water	Gas-oil ratio
	bbls.	MCF	bbls.	CFPB

Disposition of gas (vented, used on lease or sold) \_\_\_\_\_ Producing interval(s) \_\_\_\_\_

RECEIVED  
 STATE CORPORATION COMMISSION  
 OIL AND GAS DIVISION  
 WICHITA, KANSAS  
 JUN 5 1975

INSTRUCTIONS: As provided in KCC Rule 82-2-125, within 90 days after completion of a well, one completed copy of this Drillers Log shall be transmitted to the State Geological Survey of Kansas, 4150 Monroe Street, Wichita, Kansas 67209. Copies of this form are available from the Conservation Division, State Corporation Commission, 3830 So. Meridian (P.O. Box 17027), Wichita, Kansas 66217. Phone AC 316-522-2206. If confidential custody is desired, please note Rule 82-2-125. Drillers Logs will be on open file in the Oil and Gas Division, State Geological Survey of Kansas, Lawrence, Kansas 66044.

Operator RW Production Company

DESIGNATE TYPE OF COMP.: OIL, GAS, DRY HOLE, SWDW, ETC.:

Well No. 1

Lease Name Gates

Dry Hole

S 4 T 22 R 13 WEX W

WELL LOG

Show all important zones of porosity and contents thereof; cored intervals, and all drill-stem tests, including depth interval tested, cushion used, time tool open, flowing and shut-in pressures, and recoveries.

SHOW GEOLOGICAL MARKERS, LOGS RUN, OR OTHER DESCRIPTIVE INFORMATION.

FORMATION DESCRIPTION, CONTENTS, ETC.	TOP	BOTTOM	NAME	DEPTH
Anhydrite	737	760		
Heebner	3241			
Toronto	3261			
Douglas	3277			
Brown Lime	3371			
Lansing	3380			
Base Kansas City	3608			
Viola	3669			
Simpson Shale	3752			
Arbuckle	Not Reached			
T.D.	3770			
<p>DST Viola from 3650' to 3685'  Tool open 30 min. and shut in 45 min.  IFP 152 FFP 204 FHP 1955  Recover 340' Muddy water with a few specks of oil.</p>				

USE ADDITIONAL SHEETS, IF NECESSARY, TO COMPLETE WELL RECORD.

Date Received

*[Handwritten Signature]*  
Signature

*[Handwritten Title]*  
Title

*[Handwritten Date]*  
Date