

STATE OF KANSAS  
STATE CORPORATION COMMISSION

Give All Information Completely  
Make Required Affidavit  
Mail or Deliver Report to:  
Conservation Division  
State Corporation Commission  
211 No. Broadway  
Wichita, Kansas

WELL PLUGGING RECORD

Stafford County, Sec. 4 Twp. 22S Rge. 13W (E) (W)

Location as "NE/CNW/SE/SW" or footage from lines E/2 W/2 SW/4

Lease Owner Sterling Drilling Company

Lease Name Schartz Well No. 1

Office Address P. O. Box 127 Sterling, Kansas

Character of Well (completed as Oil, Gas or Dry Hole) Dry Hole

Date well completed 9-13 19 61

Application for plugging filed 9-12 19 61

Application for plugging approved 9-12 19 61

Plugging commenced 9-12 19 61


Plugging completed 9-13 19 61

Reason for abandonment of well or producing formation Completed as a dry hole.

If a producing well is abandoned, date of last production \_\_\_\_\_ 19 \_\_\_\_\_

Was permission obtained from the Conservation Division or its agents before plugging was commenced? Yes

NORTH

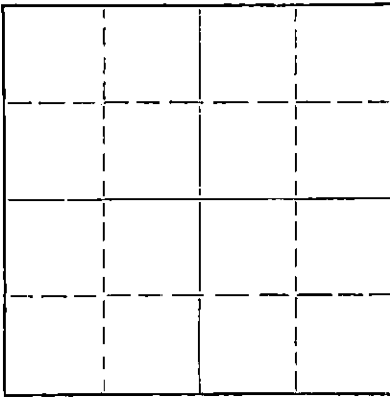

Locate well correctly on above Section Plat

Name of Conservation Agent who supervised plugging of this well Frank Broadfoot

Producing formation \_\_\_\_\_ Depth to top \_\_\_\_\_ Bottom \_\_\_\_\_ Total Depth of Well 3822 Feet

Show depth and thickness of all water, oil and gas formations.

OIL, GAS OR WATER RECORDS

CASING RECORD

FORMATION	CONTENT	FROM	TO	SIZE	PUT IN	PULLED OUT
Sand				8 5/8"	313'	

Describe in detail the manner in which the well was plugged, indicating where the mud fluid was placed and the method or methods used in introducing it into the hole. If cement or other plugs were used, state the character of same and depth placed, from \_\_\_\_\_ feet to \_\_\_\_\_ feet for each plug set.

Filled hole with heavy mud through drill pipe to 240'.  
Halliburton plug 20 sacks cement and hulls at 240'.  
Heavy mud to 35'. Halliburton plug and hulls 10 sacks  
cement up to the base of cellar. 2 sacks cement in rat hole.

RECEIVED  
STATE CORPORATION COMMISSION

SEP 13 1961  
CONSERVATION DIVISION

(If additional description is necessary, use BACK of this sheet)

Name of Plugging Contractor Sterling Drilling Company  
Address P. O. Box 127, Sterling, Kansas

STATE OF Kansas, COUNTY OF Rice, ss. F. A. Wuellner

(employee of owner) or (owner or operator) of the above-described well, being first duly sworn on oath, says: That I have knowledge of the facts, statements, and matters herein contained and the log of the above-described well as filed and that the same are true and correct. So help me God. STERLING DRILLING COMPANY

(Signature) By: F. A. Wuellner  
F. A. Wuellner, Secretary  
Sterling, Kansas  
(Address)

SUBSCRIBED AND SWORN TO before me this 13th day of September, 19 61

Bernard Sandersmith  
Notary Public.

My commission expires Jan. 22, 1962



STERLING DRILLING COMPANY  
Sterling, Kansas

WELL LOG ----- SCHARTZ #1

Located: E/2 W/2 SW/4 Section 4-22S-13W, Stafford County, Kansas

OWNER: Sterling Drilling Company  
ROTARY DRILLING CONTRACTOR: Sterling Drilling Company

COMMENCED: 9-3-51

COMPLETED: 9-13-51

ROTARY TOTAL DEPTH: 3822'

LOG

0	=	160	Sand
160	=	325	Red Bed
325	=	935	Red Bed & Shale
935	=	1180	Shale
1180	=	1915	Lime & Shale
1915	=	2040	Lime
2040	=	2315	Shale & Lime
2315	=	2475	Lime
2475	=	2810	Shale & Lime
2810	=	3160	Lime
3160	=	3230	Lims & Shale
3230	=	3290	Lime
3290	=	3391	Shale
3391	=	3404	Brown Lime
3404	=	3450	Lansing Kansas City
3450	=	3730	Lims
3730	=	3758	Viola
3758	=	3790	Shale (Simpson)
3790	=	3813	Shale
3813	=	3822	Lime & Arbuckle T.D.

CASING RECORD

Set 8 5/8" Surface Casing  
@ 321' K.B. with 275 Sacks  
HA 5 Cement.

**RECEIVED**  
STATE CORPORATION COMMISSION

SEP 15 1961

CONSERVATION DIVISION  
Wichita, Kansas

Plugged & Abandoned.