


WELL PLUGGING RECORD

Give All Information Completely
Make Required Affidavit
Mail or Deliver Report to:
Conservation Division
State Corporation Commission
800 Bittling Building
Wichita, Kansas

NORTH

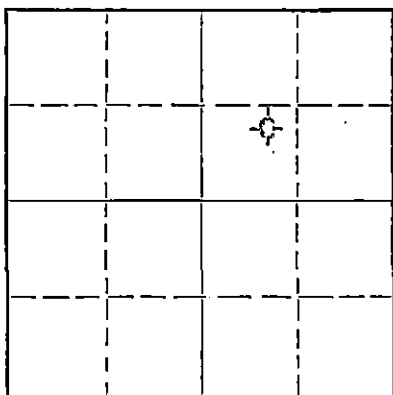

Locate well correctly on above
Section Plat

Stefford County. Sec. 11 Twp. 22S Rge. (E) 13(W)
Location as "NE/CNW $\frac{1}{4}$ /SW $\frac{1}{4}$ " or footage from lines NE $\frac{1}{4}$ SW $\frac{1}{4}$ NE $\frac{1}{4}$
Lease Owner Derby Drilling Company
Lease Name Gates "D" Well No. 1
Office Address 352 North Broadway, Wichita 2, Kansas
Character of Well (completed as Oil, Gas or Dry Hole) Dry Hole
Date well completed March 4, 1952
Application for plugging filed March 4, 1952
Application for plugging approved March 4, (Verbal) 1952
Plugging commenced March 4, 1952
Plugging completed March 4, 1952
Reason for abandonment of well or producing formation Dry Hole

If a producing well is abandoned, date of last production 19
Was permission obtained from the Conservation Division or its agents before plugging was commenced? Yes

Name of Conservation Agent who supervised plugging of this well
Producing formation Depth to top Bottom Total Depth of Well 3775 Feet
Show depth and thickness of all water, oil and gas formations.

OIL, GAS OR WATER RECORDS

CASING RECORD

Formation	Content	From	To	Size	Put In	Pulled Out
				3-5/8	286'	None

Describe in detail the manner in which the well was plugged, indicating where the mud fluid was placed and the method or methods used in introducing it into the hole. If cement or other plugs were used, state the character of same and depth placed, from feet to feet for each plug set.

Filled hole with mud to 270'. Set plug.
Cemented with 15 sacks. Filled hole with
mud to 35'. Set plug. Cemented with 10 sacks.

(If additional description is necessary, use BACK of this sheet)
Name of Plugging Contractor Rocket Drilling Company
Address 352 North Broadway, Wichita 2, Kansas

STATE OF Kansas, COUNTY OF Sedgewick, ss.
H. W. Watchous (employee of owner) or (owner or operator) of the above-described well,
being first duly sworn on oath, says: That I have knowledge of the facts, statements, and matters herein contained and the log of the above-described well as filed and that the same are true and correct. So help me God.

(Signature) *H. W. Watchous*
352 North Broadway, Wichita 2, Kansas
(Address)

SUBSCRIBED AND SWORN to before me this 7th day of March, 1952

My commission expires Dec. 3, 1955
Barbara A. Hensley
Notary Public

PLUGGING
FILE SEC 4 T 22 R 13
PAGE 149 LINE 25

3-8-52

ROCKET DRILLING COMPANY
 352 North Broadway
Wichita 2, Kansas

Derby Drilling Company, Etal
 352 North Broadway
 Wichita 2, Kansas

#1 Gates "B"
 NE SW NE; 4-22-13W
 Stafford County, Kansas

Elevation: 1891 Gr.; 1894 D.F.; 1896 R.B.
 Spudded: February 22, 1952
 Rotary Completed: March 4, 1952
 Cable Tools Completed: None
 Acid Treatment: None
 Contractor: Rocket Drilling Company

CASING RECORD

286' 8-5/8" O. D. 28# Seamless Casing Cemented W/225 Sacks Cement.
 5-1/2" None

DRILLERS LOG

Sand	0 to 247	Lime & Shale	2235 to 2268
Blue Shale	275	Sandy Lime	2280
Red Shale	286	Lime	2325
Red Bed & Shale	746	Shale	2535
Anhydrite	775	Shale & Lime	2870
Shale & Salt	1320	Lime	3224
Lime & Shale	1667	Lime & Shale	3306
Shale & Lime	1815	Shale & Lime	3372
Lime	1925	Lime	3660
Lime & Shale	1984	Chert	3703
Sand	2010	Chert & Shale	3734
Shale	2070	Arbuckle	3768-3775 TD
Shale & Lime	2235		

STATE OF KANSAS) SS:
 SEDGWICK COUNTY)

I hereby certify that to the best of my knowledge and belief,
 the foregoing log is true and correct.

PLUGGING
 FILE NO. 4-22-13W
 DATE 142-11-25

ROCKET DRILLING COMPANY
 By [Signature]

Subscribed and sworn to before me, a Notary Public, in and for
 the State and County aforesaid this 7th day of March, 1952.

My Commission Expires: 12-3-55

[Signature]
 Notary Public