


STATE OF KANSAS
STATE CORPORATION COMMISSION

Give All Information Completely
Make Required Affidavit
Mail or Deliver Report to:
Conservation Division
State Corporation Commission
800 Bitting Building
Wichita, Kansas

WELL PLUGGING RECORD

Stafford County, Sec. 4 Twp. 22 Rge. (E) 13 (W)
Location as "NE/CNW 1/4 SW 1/4" or footage from lines SE NW SE
Lease Owner Kewanee Oil Company
Lease Name Moon Well No. 2
Office Address P. O. Box 432, Ellinwood, Kansas
Character of Well (completed as Oil, Gas or Dry Hole) Dry Hole
Date well completed 10-22 1950
Application for plugging filed (Verbal Approval) 10-24 1950
Application for plugging approved Verbal Approval 10-21 1950
Plugging commenced 10-22 1950
Plugging completed 10-22 1950
Reason for abandonment of well or producing formation Dry Hole

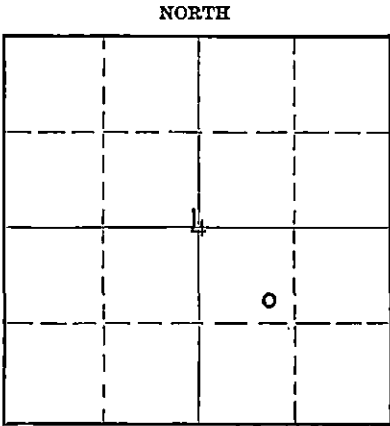

Locate well correctly on above
Section Flat

If a producing well is abandoned, date of last production 19...
Was permission obtained from the Conservation Division or its agents before plugging was commenced? Yes

Name of Conservation Agent who supervised plugging of this well Mr. C. D. Stough
Producing formation Depth to top Bottom Total Depth of Well 3910 Feet
Show depth and thickness of all water, oil and gas formations.

OIL, GAS OR WATER RECORDS

CASING RECORD

| Formation | Content | From | To | Size | Put In | Pulled Out |
|-------------------|---------|------|------|--------|--------|------------|
| | | 0 | 308 | 8-5/8" | 306 | 0 |
| Kansas City | Dry | 3396 | | | | |
| Reworked Arbuckle | Dry | 3828 | 3910 | | 0 | 0 |

Describe in detail the manner in which the well was plugged, indicating where the mud fluid was placed and the method or methods used in introducing it into the hole. If cement or other plugs were used, state the character of same and depth placed, from... feet to... feet for each plug set.

Filled hole with 10# mud.
Pumped Halliburton plug to 300'
Halliburton pumped 28 sacks of cement thru drill pipe on top of plug.
Pumped second Halliburton plug to 30' and filled to cellar with 12 sacks cement.

10-25-50
RECEIVED
STATE CORPORATION COMMISSION
OCT 25 1950
CONSERVATION DIVISION
Wichita, Kansas

(If additional description is necessary, use BACK of this sheet)

Correspondence regarding this well should be addressed to Kewanee Oil Company
Address P. O. Box 432, Ellinwood, Kansas

STATE OF Kansas, COUNTY OF Barton, ss.
G. J. Tooley (employee of owner) or (owner or operator) of the above-described well,
being first duly sworn on oath, says: That I have knowledge of the facts, statements, and matters herein contained and the log of the above-described well as filed and that the same are true and correct. So help me God.

(Signature) [Signature]
P. O. Box 432 Ellinwood, Kansas (Address)

SUBSCRIBED AND SWORN TO before me this 24th day of Oct, 1950
Henry S. Benson, Jr. Notary Public.

My commission expires Dec 24 1950

28-8278-s 4-50-10M
PLUGGING
FILE SEC 4 T 22 R 13 W
BOOK PAGE 37 LINE 45

KEWANEE OIL COMPANY

Well Record: Moon #2 Elevation: 1892' G.L.

Location: SE NW SE Section 4, T. 22S., R. 13W., Stafford County, Kansas

Drilling Commenced: 10-9-50 Drilling Completed: 10-22-50

Treating Record: Was Not Treated

Initial Production: Dry

Tops as Follows:

| | | |
|---------------------|------|---------|
| Heebner Shale | 3257 | (-1365) |
| Brown Lime | 3384 | (-1492) |
| Lansing-K.C. | 3396 | (-1504) |
| Viola Chert | 3712 | (-1820) |
| Simpson | 3764 | (-1872) |
| Arbuckle (reworked) | 3828 | (-1936) |
| Total Depth | 3910 | (-2018) |

Casing Record

8-5/8" O.D. Casing set at 306' G.L. w/ 200 sacks 3% gal cement.

Formation Record

| | | | |
|------|----------------------|------|----------------------|
| 0 | Surface | 3225 | Lime |
| 285 | Sand | 3263 | Shale |
| 315 | Red Bed | 3308 | Shale & lime streaks |
| 743 | Red Bed & shale | 3400 | Shale & lime |
| 768 | Anhydrite | 3692 | Lime |
| 1096 | Shale & shells | 3725 | Conglomerate |
| 1229 | Salt & shale streaks | 3744 | Cherty lime |
| 1463 | Shale & lime streaks | 3754 | Lime & chert |
| 1941 | Shale & lime | 3784 | Sand (Simpson) |
| 2325 | Lime | 3895 | Conglomerate |
| 2891 | Shale & lime | 3904 | Dolomite |
| 2997 | Lime | 3910 | Conglomerate |
| 3020 | Lime & shale | 3910 | Total Depth |

Slope Tests

| | |
|-------------------------|----------|
| Ran Totco at 500' hole | 1/8° off |
| Ran Totco at 1000' hole | 1/8° off |
| Ran Totco at 1500' hole | 1/8° off |
| Ran Totco at 1750' hole | okay |
| Ran Totco at 2050' hole | 1/8° off |
| Ran Totco at 2300' hole | 3/4° off |
| Ran Totco at 2330' hole | 1/8° off |
| Ran Totco at 2450' hole | 1/8° off |
| Ran Totco at 2700' hole | okay |
| Ran Totco at 2860' hole | 1/8° off |
| Ran Totco at 3040' hole | 1/8° off |
| Ran Totco at 3085' hole | 1/8° off |
| Ran Totco at 3130' hole | 1/8° off |
| Ran Totco at 3485' hole | 1/8° off |

RECEIVED
OCT 25 1950
CONSERVATION DIVISION
STAFFORD COUNTY

LANDING
MOON #2
4-2-13w
37-45