

12
92


STATE OF KANSAS
STATE CORPORATION COMMISSION

Form CP-4

Give All Information Completely
Make Required Affidavit
Mail or Deliver Report to:
Conservation Division
State Corporation Commission
211 No. Broadway
Wichita, Kansas

WELL PLUGGING RECORD

NORTH

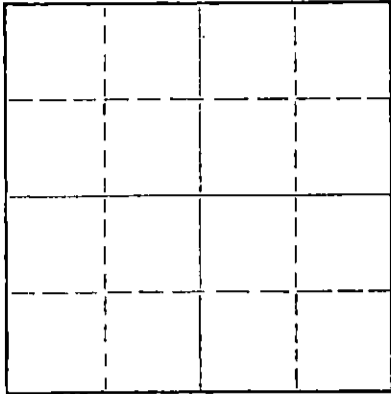

Locate well correctly on above
Section Plat

Stafford County, Sec. 4 Twp. 22 Rge. 13 (E) W (W)
Location as "NE/CNW&SW&" or footage from lines NW NW NE
Lease Owner Kirby Petroleum Co.
Lease Name Gates "A" Well No. 3
Office Address 402 First National Bank Building, Pawhuska, Oklahoma
Character of Well (completed as Oil, Gas or Dry Hole) Dry Hole
Date well completed November 21 19 65
Application for plugging filed By phone - November 21 19 65
Application for plugging approved By phone - November 21 19 65
Plugging commenced 5:00 p.m. - November 21, 19 65
Plugging completed 10:15 p.m. - November 21, 19 65
Reason for abandonment of well or producing formation Drilled dry -
no production found
If a producing well is abandoned, date of last production _____ 19 ____
Was permission obtained from the Conservation Division or its agents before plugging was com-
menced? Yes

Name of Conservation Agent who supervised plugging of this well Archie Elving
Producing formation none Depth to top _____ Bottom _____ Total Depth of Well 3758 Feet
Show depth and thickness of all water, oil and gas formations.

OIL, GAS OR WATER RECORDS

CASING RECORD

FORMATION	CONTENT	FROM	TO	SIZE	PUT IN	PULLED OUT
none				8 5/8"	325'	none

Describe in detail the manner in which the well was plugged, indicating where the mud fluid was placed and the method or methods used in introducing it into the hole. If cement or other plugs were used, state the character of same and depth placed, from _____ feet to _____ feet for each plug set.

Hole filled with heavy mud and plugged as follows: Plugged at 260'
with 1/2 sack of hulls and 25 sacks of cement and mud to 40'; plugged at 40' with
1/2 sack of hulls and 10 sacks of cement. 2 sacks of cement in rat hole and 2 sacks
of cement in mouse hole.

RECEIVED
STATE CORPORATION COMMISSION
12-3-65
DEC - 3 1965

CONSERVATION DIVISION
Wichita, Kansas

(If additional description is necessary, use BACK of this sheet)

Name of Plugging Contractor Strata Drilling, Inc.
Address 2421 Tenth Street, Great Bend, Kansas 67530

STATE OF Oklahoma, COUNTY OF Osage, ss.
G.R. Corley, District Superintendent (employee of owner) or (owner or operator) of the above-described well, being first duly sworn on oath, says: That I have knowledge of the facts, statements, and matters herein contained and the log of the above-described well as filed and that the same are true and correct. So help me God.

(Signature) G.R. Corley
402 First National Bank Building, Pawhuska, Okla.
(Address)

SUBSCRIBED AND SWORN to before me this 2nd day of December, 19 65
Doris L. Belk

My commission expires August 18, 1968 Notary Public.

D R I L L E R S L O G

#3 Gates "A"

CASING RECORD:
Ran 318.81' of new
8-5/8" surface
casing.
TOTAL DEPTH:
3758'

COMPANY: Kirby Petroleum Company
CONTRACTOR: Strata Drilling, Inc.
COMMENCED: November 11, 1965
COMPLETED: November 21, 1965

DESCRIPTION: NW NW NE
Section 4-22S-13W
Stafford County, Kansas

D. & A.

<u>FORMATION</u>	<u>FROM</u>	<u>TO</u>	<u>REMARKS</u>
Sand	0	250	Ran 318.81' of new 8-5/8" surface casing; set and cemented at 325' with 285 sacks of cement, 2% gel and 3% calcium chloride. Plug down at 1:30 P. M. November 12, 1965. Cement circulated.
Red Bed & Shale	250	325	
Red Bed	325	745	
Anhydrite	745	770	
Shale	770	1295	
Shale & Red Bed	1295	1834	
Lime & Shale	1834	3467	
Lime	3467	3590	
Lime & Chert	3590	3663	
Chert, Lime & Shale	3663	3706	
Shale & Lime	3706	3716	Ran two drill stem test and one core test.
Shale & Sand	3716	3735	
Chert, Lime & Shale	3735	3758	

Total Depth 3758'

Plugged as follows: Plugged at 260' with $\frac{1}{4}$ sack of hulls and 25 sacks of cement and mud to 40'; plugged at 40' with $\frac{1}{4}$ sack of hulls and 10 sacks of cement. 2 sacks of cement in rat hole and 2 sacks of cement in mouse hole. Job completed at 10:15 P. M. November 21, 1965.

STATE OF KANSAS)
) ss.
COUNTY OF BARTON)

I certify that this is a true and correct copy of the above log to the best of my knowledge.

STRATA DRILLING, INC.

Charles W. Steincamp
Charles W. Steincamp, President

Subscribed and sworn to before me this 23rd day of November, 1965.

Elaine H. Taylor
Elaine H. Taylor, Notary Public

My Commission Expires:
December 14, 1965

RECEIVED
STATE CORPORATION COMMISSION

DEC - 3 1965

CONSERVATION DIVISION
Topeka, Kansas