


WELL PLUGGING RECORD

Give All Information Completely
Make Required Affidavit
Mail or Deliver Report to:
Conservation Division
State Corporation Commission
800 Pitting Building
Wichita, Kansas

NORTH

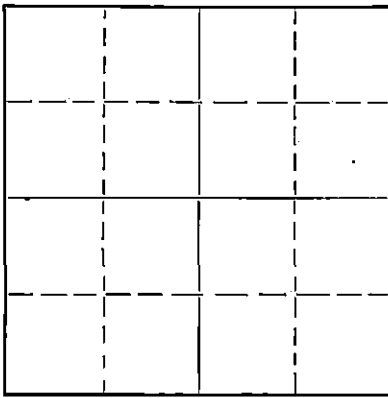

Locate well correctly on above
Section Plat

Stafford County. Sec. 4 Twp. 22 Rge. 13 (E) (W)
Location as "NE/CNW $\frac{1}{4}$ SW $\frac{1}{4}$ " or footage from lines NE NW NW
Lease Owner Francis Raymond
Lease Name Chadd Well No. 1
Office Address 202 Bissantz Bldg. Wichita, Kansas
Character of Well (completed as Oil, Gas or Dry Hole) Oil
Date well completed 11-29 19 48
Application for plugging filed 10-21 19 50
Application for plugging approved 10-21 19 50
Plugging commenced 10-21 19 50
Plugging completed 10-21 19 50
Reason for abandonment of well or producing formation Dry

If a producing well is abandoned, date of last production 19
Was permission obtained from the Conservation Division or its agents before plugging was commenced? Yes

Name of Conservation Agent who supervised plugging of this well C. D. Stough Great Bend, Kansas
Producing formation Arbuckle Depth to top 3750 Bottom 3761 Total Depth of Well 3761 Feet
Show depth and thickness of all water, oil and gas formations.

OIL, GAS OR WATER RECORDS

CASING RECORD

Formation	Content	From	To	Size	Put In	Pulled Out
Surface		-0-	321'	8 5/8"	321'	-0-
Oil string		-0-	3754'	5 1/2"	3754'	2290'

Describe in detail the manner in which the well was plugged, indicating where the mud fluid was placed and the method or methods used in introducing it into the hole. If cement or other plugs were used, state the character of same and depth placed, from _____ feet to _____ feet for each plug set.

Filled with heavy mud to 321'
15 sx cement @ 321'
10 sx cement @ surface

RECEIVED
STATE CORPORATION COMMISSION
JAN 26 1951
CONSERVATION DIVISION
WICHITA, KANSAS

1-26-51

(If additional description is necessary, use BACK of this sheet)
Correspondence regarding this well should be addressed to Flournoy & Williams
Address Box 270 Hoisington, Kansas

STATE OF Kansas, COUNTY OF Sedgwick, ss.
Chester Williams (employee of owner) or (owner or operator) of the above-described well,
being first duly sworn on oath, says: That I have knowledge of the facts, statements, and matters herein contained and the log of the above-described well as filed and that the same are true and correct. So help me God.

(Signature) *Chester Williams*
901 Brown Building Wichita, Kansas
(Address)

SUBSCRIBED AND SWORN to before me this 24 day of January 19 51

My commission expires 3/27/54
Notary Public.

PLUGGING
FILE SEC 4 T22 R13W
BOOK PAGE 37 LINE 44

15-185-12804-0000

Company The Phil-Han Oil Company

Chad #1 NE NW NW
 Sec. 4-22-13W
 Stafford, Co., Kansas

Commenced 11-15-48
 Completed 11-29-48

Casing 8 5/8" 321' cem w/200sx
 5 1/2" 3754' " w/250sx

<u>Formation</u>	<u>Depth</u>
Shale, shells	65
Sand	200
Shale, shells	321
Redbed	760
Anhydrite	790
Shale, shells	1050
Redbed, shale, shells	1400
Shale, shells	1575
Shale, lime	1675
Shale, shells	1800
Lime	1975
Shale, lime	2060
Shale	2245
Shale, shells	2340
Shale	2550
Lime, Shale	2580
Shale, lime	2645
Shale	2715
Shale, lime	3045
Lime	3080
Shale, Lime	3100
Lime, shale	3165
Lime	3209
Lime, hard	3231
Lime, shale	3345
Lime	3635
Shale, lime	3678
Chert	3706
Lime, shale	3740
Conglomerate, Arbuckle lime	3761
Total depth	

Tops

Lansing	3379
Viola	3663
Simpson	3700
Arbuckle	3750

RECEIVED
 STATE CORPORATION COMMISSION
 JAN 26 1951
 CONSERVATION DIVISION
 Topeka, Kansas

PLUGGING
 FILE SEC 4-22-13W
 BOOK PAGE 37