


STATE OF KANSAS  
STATE CORPORATION COMMISSION

Form CP-4

WELL PLUGGING RECORD

Give All Information Completely  
Make Required Affidavit  
Mail or Deliver Report to:  
Conservation Division  
State Corporation Commission  
212 No. Market  
Wichita, Kansas 67202

NORTH

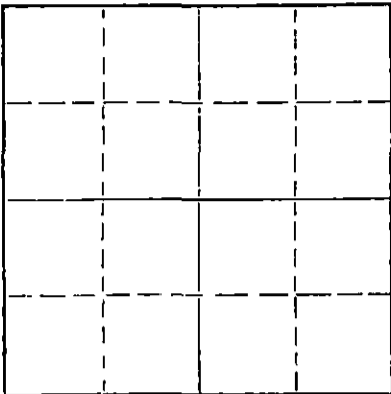

Locate well correctly on above  
Section Plat

Stafford County. Sec. 4 Twp. 22 Rge. (E) 13 (W)  
Location as "NE/CNWxSWx" or footage from lines 165' S of NW NW NW  
Lease Owner United States Hydrocarbon Co.  
Lease Name Beier Well No. 1  
Office Address Box 11027, Wichita, Kansas  
Character of Well (completed as Oil, Gas or Dry Hole) Dry Hole  
Date well completed April 7 19 71  
Application for plugging filed April 7 19 71  
Application for plugging approved April 7 19 71  
Plugging commenced April 7 19 71  
Plugging completed April 7 19 71  
Reason for abandonment of well or producing formation Dry Hole

If a producing well is abandoned, date of last production 19  
Was permission obtained from the Conservation Division or its agents before plugging was commenced? Yes

Name of Conservation Agent who supervised plugging of this well G. R. Biberstein  
Producing formation Depth to top Bottom Total Depth of Well 3773 Feet  
Show depth and thickness of all water, oil and gas formations.

OIL, GAS OR WATER RECORDS

CASING RECORD

FORMATION	CONTENT	FROM	TO	SIZE	PUT IN	PULLED OUT
				8 5/8	291	

Describe in detail the manner in which the well was plugged, indicating where the mud fluid was placed and the method or methods used in introducing it into the hole. If cement or other plugs were used, state the character of same and depth placed, from feet to feet for each plug set.

Bottom plug @ 500' w/40 sx.  
Middle plug @ 265' w/20 sx.  
Top plug @ 40' w/10 sx.

RECEIVED  
STATE CORPORATION COMMISSION  
APR 12 1971  
CONSERVATION DIVISION  
Wichita, Kansas

(If additional description is necessary, use BACK of this sheet)  
Name of Plugging Contractor Woodman & Iannitti Drilling Company  
Address 706 Union National Building

STATE OF KANSAS, COUNTY OF SEDGWICK, ss.  
K. T. Woodman (employee of owner) or (owner or operator) of the above-described well, being first duly sworn on oath, says: That I have knowledge of the facts, statements, and matters herein contained and the log of the above-described well as filed and that the same are true and correct. So help me God.

(Signature) K. T. Woodman

706 Union National Bldg.  
(Address)

SUBSCRIBED AND SWORN TO before me this 9th day of April, 19 71

My commission expires Feb. 11, 1972

Justina Chamberlain  
Justina Chamberlain Notary Public.

15-185-20342-0000

K. T. WOODMAN  
RES. PHONE AM 5-3572  
OFFICE PH. AM 5-7650  
WICHITA, KANSAS

D. J. IANNITTI  
TELEPHONE 653-2381  
HOISINGTON, KANSAS

# WOODMAN & IANNITTI DRILLING COMPANY

Rotary Drilling Contractors

706 UNION NATIONAL BUILDING

WICHITA, KANSAS 67202

April 9, 1971

Company;	United States Hydrocarbon Co.
Farm;	#1 Beier
Location;	165' S of NW NW NW
Section;	4-22-13W
County;	Stafford
Comm;	March 31, 1971
Compl;	April 7, 1971
Total Depth	3773'
Casing;	8 5/8" @291 w/250 sacks
Production;	D & A

Figures Indicate Bottom Of Formations:

270	Sand
292	Red Bed
550	Shale
752	Red Bed
785	Anhy
1145	Shale & Shells
1625	Shale & Shells
1715	Shale & Lime
1900	Shale & Lime
2055	Lime
2275	Lime
2555	Shale & Lime
2765	Lime
2915	Lime
3060	Lime & Shale
3182	Lime
3290	Lime
3405	Lime
3486	Lime
3570	Lime
3575	Lime
3665	Lime
3718	Lime
3773	Lime

RECEIVED  
STATE CORPORATION COMMISSION  
APR 12 1971  
CONSERVATION DIVISION  
Wichita, Kansas

I certify the above to be a true and correct copy of the driller's log and the geological tops to the best of my knowledge and belief.

Woodman & Iannitti Drilling Co.

*K. T. Woodman*  
K. T. Woodman