

STATE OF KANSAS
STATE CORPORATION COMMISSION

Form CP-4

Give All Information Completely
Make Required Affidavit
Mail or Deliver Report to:
Conservation Division
State Corporation Commission
212 No. Market
Wichita, Kansas 67202

WELL PLUGGING RECORD

Stafford County, Sec. 4 Twp. 22S Rge. 13 ~~(E)~~ W (W)

Location as "NE/CNWSW" or footage from lines 990' E. of W & 810' S. of N

Lease Owner United States Hydrocarbon Company

Lease Name Chase Well Service Well No. 2

Office Address Box 11027, Washington Street Station, Wichita, Kansas 67202

Character of Well (completed as Oil, Gas or Dry Hole) Dry Hole

Date well completed May 7 19 71

Application for plugging filed May 7 19 71

Application for plugging approved May 7 19 71


Plugging commenced May 7 19 71

Plugging completed May 8 19 71

Reason for abandonment of well or producing formation No Productible Zone

If a producing well is abandoned, date of last production _____ 19 _____

Was permission obtained from the Conservation Division or its agents before plugging was commenced? Yes

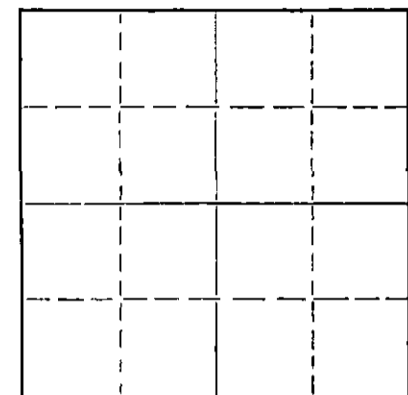

Locate well correctly on above Section Plat

Name of Conservation Agent who supervised plugging of this well G. R. Biberstein

Producing formation _____ Depth to top _____ Bottom _____ Total Depth of Well 3800 Feet

Show depth and thickness of all water, oil and gas formations.

OIL, GAS OR WATER RECORDS

CASING RECORD

| FORMATION | CONTENT | FROM | TO | SIZE | PUT IN | PULLED OUT |
|-----------|---------|------|----|-------|--------|------------|
| | | | | 8 5/8 | 290 | 0 |
| | | | | | | |
| | | | | | | |
Describe in detail the manner in which the well was plugged, indicating where the mud fluid was placed and the method or methods used in introducing it into the hole. If cement or other plugs were used, state the character of same and depth placed, from _____ feet to _____ feet for each plug set.

Gunned up pits forming heavy mud. Filled hole with heavy mud and spotted 40 sacks cement at 600 feet. Filled hole with heavy mud and spotted 25 sacks cement at 280 feet. Filled hole with heavy mud, pushed 1/2 sack hulls and wooden plug to 40 feet. Capped with 10 sacks cement to base of well cellar. Job complete at 1:30 AM, May 8, 1971.

RECEIVED
STATE CORPORATION COMMISSION
MAY 13 1971
CONSERVATION DIVISION
Wichita, Kansas

(If additional description is necessary, use BACK of this sheet)

Name of Plugging Contractor Garvey Drilling Company

Address Box 1164, Great Bend, Kansas 67530

STATE OF Kansas, COUNTY OF Barton, ss.

Ben E. Unruh (employee of owner) ~~owner or operator~~ of the above-described well, being first duly sworn on oath, says: That I have knowledge of the facts, statements, and matters herein contained and the log of the above-described well as filed and that the same are true and correct. So help me God.

(Signature) Ben E. Unruh

Box 1164, Great Bend, Kansas 67530
(Address)

SUBSCRIBED AND SWORN TO before me this 12th day of May, 19 71

Gene A. Morris
Notary Public.

My commission expires July 8, 1974

WELL LOG

COMPANY United States Hydrocarbon Company

SEC. 4 T. 22S R. 13W

FARM Chase Well Service NO. 2


LOC. 990' E of W line & 810' S of N line

TOTAL DEPTH 3800'

COUNTY Stafford; Kansas

COMM. 4-29-71 COMP. 5-8-71

CONTRACTOR Garvey Drilling Company

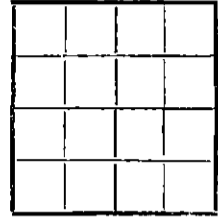

CASING
8 5/8" @ 290' w/365sx

ELEVATION

PRODUCTION D & A

FIGURES INDICATE BOTTOM OF STRATIGRAPHY

- 30' Surface Soil & Sand
- 290' Sand & Shale
- 480' Shale & Red Bed
- 752' Red Bed & Shale
- 775' Anhydrite
- 1095' Shale
- 1625' Shale & Lime
- 1865' Lime
- 2730' Shale
- 2978' Shale & Lime
- 3335' Lime & Shale
- 3390' Shale & Lime
- 3410' Lime
- 3680' Lime & Chert
- 3743' Chert & Shale
- 3770' Lime & Shale
- 3800' Lime & Shale
- 3800' RTD

RECEIVED
STATE CORPORATION COMMISSION
MAY 13 1971
CONSERVATION DIVISION
Wichita, Kansas

State of Kansas }
County of Barton } SS

I, Charlene Marker of Garvey Drilling Company

upon oath state the above and foregoing is a true and correct copy of the log of the Chase Well Service No. 2 well.

Subscribed and sworn to before me this 11th day of May 1971
Charlene Marker

My Commission Expires: July 8, 1974

James C. [Signature]
NOTARY PUBLIC