


STATE OF KANSAS
STATE CORPORATION COMMISSION

Give All Information Completely
Make Required Affidavit
Mail or Deliver Report to:
Conservation Division
State Corporation Commission
212 North Market, Insurance Bldg.
Wichita, Kansas

WELL PLUGGING RECORD

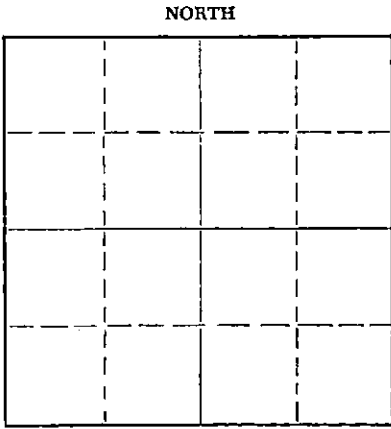

Locate well correctly on above Section Plat

Stafford County, Sec. 4 Twp. 22 Rge. I3 (E) (W)
Location as "NE/CNW/SW" or footage from lines 330' South & 990' West N/4
Lease Owner Morgenstern & Specter corner
Lease Name Mueller "B" Well No. 1
Office Address Russell, Kansas
Character of Well (completed as Oil, Gas or Dry Hole) oil
Date well completed 12-5-49 19__
Application for plugging filed June 11, 1960 19__
Application for plugging approved June 15, 1960 19__
Plugging commenced 6/13/60 19__
Plugging completed 6/16/60 19__
Reason for abandonment of well or producing formation failure to produce profitably
If a producing well is abandoned, date of last production June 19 60
Was permission obtained from the Conservation Division or its agents before plugging was commenced? Yes

Name of Conservation Agent who supervised plugging of this well Frank Broadfoot, St John, Kansas
Producing formation Kansas City Depth to top 3380 Bottom 3650 Total Depth of Well 3762 Feet
Show depth and thickness of all water, oil and gas formations.

OIL, GAS OR WATER RECORDS

CASING RECORD

FORMATION	CONTENT	FROM	TO	SIZE	PUT IN	PULLED OUT
				8 5/8" OD	336 ft.	none
				5 1/2" OD	3753	2659 feet

Describe in detail the manner in which the well was plugged, indicating where the mud fluid was placed and the method or methods used in introducing it into the hole. If cement or other plugs were used, state the character of same and depth placed, from _____ feet to _____ feet for each plug set.

Plugged back with sand to 3370 feet. Dumped 5 sacks Cement. Pumped 38 barrels of Mud. And 75 sacks Cement.

RECEIVED
STATE CORPORATION COMMISSION

JUL 11 1960

CONSERVATION DIVISION
Wichita, Kansas

7-11-60

(If additional description is necessary, use BACK of this sheet)
Name of Plugging Contractor E. & L. CASING PULLING COMPANY NO. 377
Address GREAT BEND, KANSAS

STATE OF Kansas COUNTY OF Russell, ss.
Morgenstern & Specter, Inc. (employee of owner) or (owner or operator) of the above-described well, being first duly sworn on oath, says: That I have knowledge of the facts, statements, and matters herein contained and the log of the above-described well as filed and that the same are true and correct. So help me God.

(Signature) [Signature]
Russell, Kansas (Address)

SUBSCRIBED AND SWORN TO before me this 18th day of June, 19 60.

My commission expires March 9, 1962
W. V. Dawson Notary Public.



WELL LOG BUREAU KANSAS GEOLOGICAL SOCIETY
508 East Murdock, Wichita, Kansas


COPY

Company: CITIES SERVICE OIL CO.
Farm: Mueller "B" No. 1

SEC. 4 T. 22 R. 13W
NW NE NW
330' S, 990' W of N/4 corner

Total Depth. 3762 PB 3759
Comm. 11-10-49 Comp. 12-5-49
Shot or Treated. acid
Contractor. Holm-Louis Drlg.
Issued. 3-4-50.

County. Stafford
KANSAS

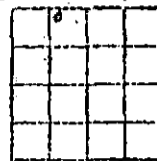

Elevation. _____

Production. Phys. Pot. 22 oil,
37 water.

CASING:

8 5/8" 336' cem w/250 sx.
5 1/2" 3753' cem w/175 sx.

Figures indicate Bottom of Formations.

sand	250
lime, shale	290
shale red	320
shale, shells	336
shells, shale, red bed	554
red bed	755
anhydrite	785
shale, shells, sand	1440
shale, lime, shells	1560
lime, shale	1673
lime	1805
lime, shale	3045
lime	3130
lime, shale	3195
lime	3280
shale	3365
lime	3753
lime, shale	3757
3757 RTD = 3757 SLM	
lime	3762
Total depth	

Tops:	
Lansing	3380
Cherty Conglomerate	3651
Viola	3666
Simpson shale	3701
Arbuckle	3751
Penetration	11'
P. B. penetration	8'
P. B. total depth	3759

Fillup:

180' fluid in 1 1/2 hrs.
356' fluid in 2 1/2 hrs.
500' fluid in 4 hrs. 25 mins.
690' fluid in 8 hrs. 25 mins.
1260' fluid in 18 hrs. 25 mins.
Pumped 17 oil, 25 wtr, 14 hrs.
12-9-49, plugged back w/cement 3762-3759 SLM.
12-10-49, acid 500 gals.
12-13-49, pumped 18 oil, 28 wtr, 24 hrs.
12-14-49, acid 1500 gals.
12-16-49, pumped 19 oil, 46 wtr, 24 hrs.