

STATE OF KANSAS
STATE CORPORATION COMMISSION

WELL PLUGGING RECORD

Give All Information Completely
Make Required Affidavit
Mail or Deliver Report to
Conservation Division
State Corporation Comm.
245 North Water
Wichita, KS 67202

Stafford County. Sec. 3 Twp. 22 Rge. 13 E/W
Location as "NE/CNW $\frac{1}{4}$ SW $\frac{1}{4}$ " or footage from lines

SE-SE-NE

Lease Owner Poor Boy Corporation

Lease Name Kinn Well No. 1

Office Address RR#2 Ellinwood, Kansas 67526

Character of Well (Completed as Oil, Gas or Dry Hole)

oil

Date Well completed 12-26 1951

Application for plugging filed 1-6 1978

Application for plugging approved 1-9 1978

Plugging commenced 4-3 1978

Plugging completed 4-3 1:30pm 1978

Reason for abandonment of well or producing formation


low-prod. & casing bad

If a producing well is abandoned, date of last production

August

1972

Was permission obtained from the Conservation Division or its agents before plugging was commenced? yes

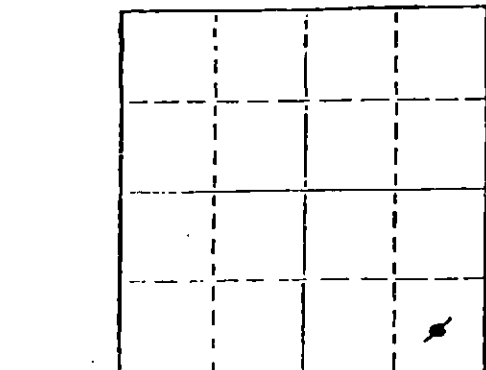

Locate well correctly on above Section Plot

Name of Conservation Agent who supervised plugging of this well William T. Owen
Producing formation arkuckle Depth to top 3708 Bottom 3736 Total Depth of Well 3736
Show depth and thickness of all water, oil and gas formations.

OIL, GAS OR WATER RECORDS

CASING RECORD

FORMATION	CONTENT	FROM	TO	SIZE	PUT IN	PULLED OUT
<u>arkuckle</u>	<u>oil</u>	<u>3708</u>	<u>3731</u>	<u>5 1/2</u>	<u>3708</u>	<u>0</u>

Describe in detail the manner in which the well was plugged, indicating where the mud fluid was placed and the method or methods used in introducing it into the hold. If cement or other plugs were used, state the character of same and depth placed, from _____ feet to _____ feet for each plug set.

Backer packer - 3340

squeezed well to 323 ft. w/ 300 sacks to surface. Through Bender head.

Drilled out to 331 ft. - went out casing.

Then squeezed again on 4-3-78 with 60 sacks 270 to surface.

Shot in with 500 lbs pressure and held.

RECEIVED
STATE CORPORATION COMMISSION

5-31-78

MAY 31 1978

(If additional description is necessary, use BACK of this sheet.)


Name of Plugging Contractor Sun Oil Well Cementing

STATE OF Kansas COUNTY OF Barton, ss.
Loren R. Hodder (employee of owner) or (owner or operator)
of the above-described well, being first duly sworn on oath, says: That I have knowledge of the facts, statements, and matters herein contained and the log of the above-described well as filed and that the same are true and correct. So help me God.

(Signature) Loren R. Hodder

RR#2 Ellinwood, Kansas 67526
(Address)

SUBSCRIBED AND SWORN TO before me this 30th day of May, 1978

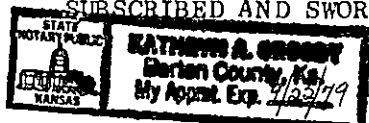

Kathryn A. Crosby
Kathryn A. Crosby Notary Public.

My commission expires Sept. 22, 1979