

WELL PLUGGING RECORD

Give All Information Completely  
Make Required Affidavit  
Mail or Deliver Report to:  
Conservation Division  
State Corporation Commission  
212 North Market, Insurance Bldg.  
Wichita, Kansas

STAFFORD County. Sec. 3 Twp. 22s Rge. 13W (#) (W)

Location as "NE/CNW%SW%" or footage from lines SW NE SW

Lease Owner PETROLEUM, INC.

Lease Name GATES "B" Well No. 5

Office Address ROUTE 2, GREAT BEND, KANSAS

Character of Well (completed as Oil, Gas or Dry Hole) OIL

Date well completed FEBRUARY 24 19 53

Application for plugging filed NOVEMBER 5 19 59

Application for plugging approved NOVEMBER 9 19 59

Plugging commenced NOVEMBER 19 19 59


Plugging completed NOVEMBER 24 19 59

Reason for abandonment of well or producing formation \_\_\_\_\_

DEPLETION OF PRODUCIBLE ZONE

If a producing well is abandoned, date of last production: OCTOBER 28 19 59

Was permission obtained from the Conservation Division or its agents before plugging was commenced? YES

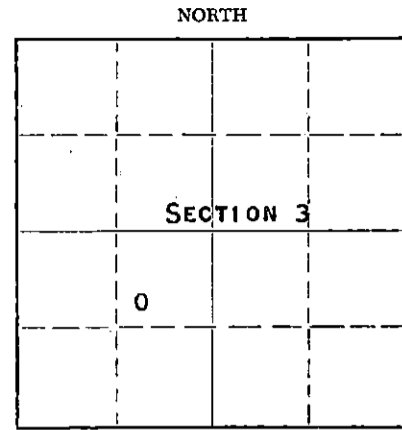

Locate well correctly on above Section Plat

Name of Conservation Agent who supervised plugging of this well FRANK BROADFOOT, 222 SOUTH MAIN, ST. JOHN, KANSAS

Producing formation ARBUCKLE Depth to top 3765' Bottom --- Total Depth of Well 3815' Feet

Show depth and thickness of all water, oil and gas formations.

OIL, GAS OR WATER RECORDS

CASING RECORD

FORMATION	CONTENT	FROM	TO	SIZE	PUT IN	PULLED OUT
ARBUCKLE	WATER & LITTLE	3767'	3771'	8-5/8"	248'	NONE
	OIL	3782'	3786'	4-1/2"	3813'	3297'

Describe in detail the manner in which the well was plugged, indicating where the mud fluid was placed and the method or methods used in introducing it into the hole. If cement or other plugs were used, state the character of same and depth placed, from \_\_\_\_\_ feet to \_\_\_\_\_ feet for each plug set.

(PLUGGED BACK TO 3801')

FILLED HOLE WITH CRUSHED ROCK FROM 3801' TO 3750'. RAN 5 SACKS OF CEMENT FROM 3750'-3700', MUD UP WITH HEAVY MUD TO 240' AND BUILT SOLID ROCK BRIDGE. PLACED 20 SACKS OF CEMENT ON TOP OF SOLID ROCK BRIDGE. MUD UP TO 35' AND BUILT SOLID ROCK BRIDGE. FILLED HOLE TO BASE OF WELL CELLAR WITH 10 SACKS OF CEMENT.

RECEIVED  
STATE CORPORATION COMMISSION

DEC 8 1959

CONSERVATION DIVISION  
WICHITA, KANSAS

12-8-59

(If additional description is necessary, use BACK of this sheet)

Name of Plugging Contractor MORGAN WELL PLUGGING SERVICE

Address 102 WEST 18TH STREET, HUTCHINSON, KANSAS

STATE OF KANSAS, COUNTY OF BARTON, ss.  
DON SEARLE (employee of owner) or (~~owner~~) of the above-described

well, being first duly sworn on oath, says: That I have knowledge of the facts, statements, and matters herein contained and the log of the above-described well as filed and that the same are true and correct. So help me God.

(Signature) Don Searle

ROUTE 2, GREAT BEND, KANSAS  
(Address)

SUBSCRIBED AND SWORN TO before me this 2ND day of DECEMBER, 19 59

Arthur J. Niles

Notary Public.

My commission expires APRIL 14, 1963



*Q*

DRILLER'S LOG GATES 'B' #5

Petroleum, Inc., Operator

Section 3, Twp. 22S, Rge 13W

Garvey Drilling Company, Contractor

Location: SW NE SW

Drilling Commenced: February 2, 1953

County: Stafford County, Kansas

Drilling Completed: February 14, 1953

R.T.D.: 3815'

Casing Record: 8 5/8" @ 248' w/175 sax  
5 1/2" @ 3813' w/75 sax

Initial Production: Arbuckle

Figures below indicate bottom of formation:

240	Sand & Shale
260	Shale & Shells
450	Red Bed & Sand
728	Shale & Shells
758	Anhydrite
1610	Shale & Shells
2425	Lime & Shale
2670	Shale & Shells
2955	Lime & Shale
3295	Lime
3380	Lime & Shale
3815	Lime
3815'	R.T.D.

Tops:

Heebner:	3230 (-1337)
Lansing:	3357 (-1464)
Simpson:	3711 (-1818)
Arbuckle:	3765 (-1872)

**RECEIVED**  
STATE CORPORATION COMMISSION

DEC 8 1959

CONSERVATION DIVISION  
Wichita, Kansas

I hereby certify that this is a true and correct log of the above mentinned well.

PETROLEUM, INC.

By *WWT*

STATE OF KANSAS )  
                          ) SS:  
COUNTY OF SEDGWICK )

Subscribed to and sworn to before me, a Notary Public, in said County and State, this 20th day of February, 1953.

*Charlotte Theisman*  
Notary Public

My commission expires: October 13, 1954.