


STATE OF KANSAS
STATE CORPORATION COMMISSION

Give All Information Completely
Make Required Affidavit
Mail or Deliver Report to:
Conservation Division
State Corporation Commission
211 No. Broadway
Wichita, Kansas

WELL PLUGGING RECORD

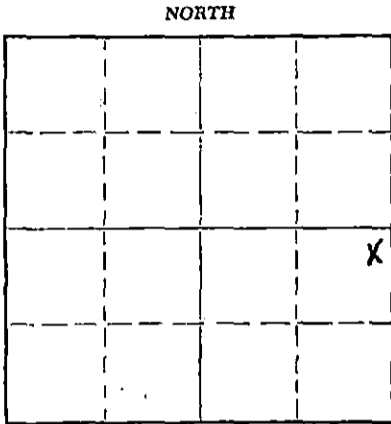

Stafford County. Sec. 3 Twp. 22 Rge. 13 (E)xx (W)
Location as "NE/CNWxSWx" or footage from lines NE NE SE
Lease Owner Kirby Petroleum Co. Supply
Lease Name Kisner, "B" Well No. 1
Office Address 402 First National Bank Building, Pawhuska, Oklahoma
Character of Well (completed as Oil, Gas or Dry Hole) Oil Well
Date well completed 12-17 1953
Application for plugging filed 8-12 1965
Application for plugging approved 8-13 1965
Plugging commenced 8-16-65 19
Plugging completed 8-19-65 19
Reason for abandonment of well or producing formation depleted

If a producing well is abandoned, date of last production August 1 1965
Was permission obtained from the Conservation Division or its agents before plugging was commenced? yes

Name of Conservation Agent who supervised plugging of this well Archie Flying
Producing formation Arbuckle Depth to top 3712 Bottom 3717 Total Depth of Well 3717 Feet
Show depth and thickness of all water, oil and gas formations.

OIL, GAS OR WATER RECORDS				CASING RECORD		
FORMATION	CONTENT	FROM	TO	SIZE	PUT IN	PULLED OUT
				8 5/8 5 1/2	270 3713	none 2789.62

Describe in detail the manner in which the well was plugged, indicating where the mud fluid was placed and the method or methods used in introducing it into the hole. If cement or other plugs were used, state the character of same and depth placed, from _____ feet to _____ feet for each plug set.

Fill hole with chat from 3717' to 3690' and dump 5 sacks cement.
Set 10' rock bridge from 250' to 240' and mix and dump 2 sacks cement, let cement set up. Bail hole dry and dump 25 sacks cement.
Mud hole to 40', set 10' rock bridge and dump 10 sacks cement.

RECEIVED
STATE CORPORATION COMMISSION
9-3-65 SEP 3 1965
CONSERVATION DIVISION
Wichita, Kansas

(If additional description is necessary, use BACK of this sheet)
Name of Plugging Contractor Flint Engineering & Construction Company
Address Box 950, El Dorado, Kansas

STATE OF KANSAS, COUNTY OF BUTLER, ss.

(employee of owner) or (owner or operator) of the above-described well, being first duly sworn on oath, says: That I have knowledge of the facts, statements, and matters herein contained and the log of the above-described well as filed and that the same are true and correct. So help me God
(Signature) James B. Bawdle
El Dorado, Kansas (Address)

SUBSCRIBED AND SWORN to before me this 24th day of August, 1965
Ronald R. Hansen
Notary Public.
My commission expires 9-27-67

TOKLAN PRODUCTION COMPANY
TULSA, OKLA.

Well: Kisner Bl

NE NE SE

Commenced RD 12-4-53
Completed RD 12-17-53Sec. 3-22-13
Stafford County, Kansas

Total Depth 3717'

Elevation:

Casing: 270' 8 5/8" O.D. 24# 8rnd
3713.66' 5 1/2" O.D. 15.5#
8rnd. thd.

Contractor: Pam-Kar

<u>STRATA</u>	<u>DEPTH</u>	<u>TOPS</u>
Surface, soil & clay	10	
Sand & Gravel	160	
Shale & sand	247	
Red Bed & shale	270	
Red Bed	724	
Anhydrite	760	
Shale	991	
Shale & Shells	1130	
Silt & shale	1295	
Shale & shells	1525	
Broken Lime	2000	
Lime	2077	
Shale & lime	2210	
Lime & shale	2310	
Shale & lime	2825	
Lime & shale	2960	
Shale & lime	3038	
Sand	3075	
Lime & shale	3205	
Shale	3329	
Lime, shale & chert	3645	
Lime, chert & shale	3690	
Lime, shale & chert	3695	
Lime & shale	3707	
Lime, shale & chert	3717	
Total Depth	3717	

I hereby certify that the above is a true and correct log of said well as reflected by the Daily Drilling reports.

PAM-KAR DRILLING COMPANY, INC.
BY

Ralph B. McLaughlin

Signed and sworn to in my presence this 29 day of December, 1953, by Ralph B. McLaughlin, Secretary-Treasurer of the Pam-Kar Drilling Company, Inc. a corporation in the State of Kansas.

W. M. Daily
Notary Public

My commission expires September 4, 1957.

RECEIVED
STATE CORPORATION COMMISSION

AUG 13 1955

CONSERVATION DIVISION
Wichita, Kansas